## digital

## DMC11

Engineering Drawings (ANNOTATED)


Digital Equipment Corporation


The material herein is for information purposes only and is subject to change without notice. Digital Equipment Corporation assumes no responsibility for any errors which may appear herein.


These drawings and specifications herein are the property of Digital Equipment Corporation and shall not be reproduced or copied or used in whole or in part as the basis for the manufacture or sale of items without written permission.


Copyright <sup>c</sup> 1975, Digital Equipment Corporation


CUSTOMER PRINT SET		T	ELECTRICAL								ER IT		MECHANICAL					
	П	MFG. SET	FIND NO.	DRAWING NO.	REV	NO OF SHT	DESCRIPTION	OPTION NO./FILE DATE			75	FIND NO.	DRAWING NO.	RE	NO OF SHT	DESCRIPTION	OPTION NO./FILE DATE	
$\dagger \dagger$	Н	7	1	D-UA-DMC11-Ø-Ø		3	INTERPROCESSOR LINK			††	╅	1	D-UA-DMC11-Ø-Ø	+-	3	INTERPROCESSOR LINK	+	
	$\Box$	$\Box$		A-PL-DMC11-Ø-7		1	DMC11 SHIPPING LIST					1					<b>†</b>	
<del>                                      </del>	$\sqcup$	4	_	B-TC-DMC11-Ø-8		1	FIELD MAINTENANCE PRINT SET			П		L					1	
₩-	$\vdash$	+								11	_	<u> </u>						
-+-	$\vdash$	$\dashv$	+	A-SP-DMC11-0-5		30	TEST AND ACCEPTANCE SPECIFICATION			++	+	╀—			↓			
	$\vdash$	+	+		$\dashv$	+	SPECIFICATION	<del></del>		+	+	╀			┼──		↓	
_		十	_		+-			-		╂┪	-	╂			┼		<del> </del>	
		1				+				+ 1	+	+		+-	+		+	
·		$\Box$								11		15	C-UA-BCØ8S-Ø-Ø		1	CABLE, BCØ8S	+	
		$\perp$	$\Box$											1			+	
-	$\sqcup$	$\dashv$	$\longrightarrow$			<del> </del>				$\bot$								
+	╁	-+			_	-				44		↓_			<u> </u>			
+	$\vdash$	+	-+			+			$\blacksquare$	++	-	+-			ļ		<del> </del>	
_		$\dashv$	2	B-DD-M82ØØ-Ø		+ <sub>1</sub>	INTERPROCESSOR LINK UP			+	+	6	D-UA-BCØ5C-Ø-Ø	+-	+-	CABLE, BCØ5C	+	
+	$\dagger$	T		B-DD-M0200-0		+-	INTERN ROCEDBON BIAN OF			+	-	╫	D-GR-Bepse-p-p	-	+-	CABLE, BCDC	+-	
								1		+ 1	+	+	<del></del>	+	+		+-	
I		$\Box$										T					+	
_ _	$\downarrow$	4	—														1.	
	$\vdash$	+				+				+	$\perp$	1			ļ		$\bot$	
+	╁┪	+				<del> </del>			+	-+-+		.   7	C-UA-BCØ5Z-Ø-Ø		1	CABLE, BCØ5Z	-	
+	+	_	$\rightarrow$		_			+	╂╌┼╴	+	+	+-			<del> </del>		+	
	T	1	3	B-DD-M82Ø1-Ø	<del></del>	$+_1$	IPL SLU LOW		╂┼	+	-	╁╌		-+-	+		+	
						† <del>-</del>		<b>†</b>		-		+-			+		+	
	П	$\Box$								+		T		-+-	†		+	
	1-1	4										9	C-UA-BCØ3N-Ø-Ø		1	CABLE, BCØ3N	+	
	$\vdash \vdash$	4	<del></del>	· · · · · · · · · · · · · · · · · · ·								$\perp$						
+-	++	+			_	<del> </del>				$\perp$								
-+	+	+	-+			+			$\blacksquare$	+		110	A-SP-3700283-0-0		<del></del>	PACKAGING INSTRUCTIONS		
_		+	-+			+			╂	+-		+	A-PS-9906040-0-0 A-PS-9905816 0-0	<del></del>		FULL TELESCOPE CARTON ASSY.  BOX, FOLDING, REVERSE TUCK	-	
		1	4	B-DD-M82Ø2-Ø	_	$+_{1}$	IPL SLU HI	+	1	+-	-	+	A-PS-9905809-0-0		+	FULL TELESCOPE CARTON ASSY.	+	
						1		<del>-  </del>		+-		十	A-PS-9905729-0-0	+-	+-	TAPE, CARTON SEALING	+-	
	Ц	$\bot$	$\Box$							+		$\top$	R-FS-3303723 0-0		$\dagger$	TATE, CARTON OBABING	+	
-	<b>├</b> - <b>┤</b>	4										11	D-UA-H325Ø		11	H3250 TEST CONNECTOR		
+	+	+								$\perp$	$oxed{\bot}$			$\perp$				
+-	+ +	+	$\dashv$			<del> </del>			╂┵	$\perp$	$\sqcup$	$\bot$	<u> </u>					
	†-{	+	-+			+			+					+	+		+	
	† †	+	8	D-CS-H325-Ø-Ø		1	H325 TEST CONNECTOR	+	$\blacksquare$	+-	+-	+	<del> </del>	+	+	+	+-	
		1			_	+-	1323 1251 COMMETON		+	+	+	+-		-+-	+	<del></del>	+	
$\bot$		1						1		+-	+	†		+	+		+	
USTO				PRINT OF DOCUMENT INCL					TIT	LE				T		SIZE CODE NUMBER	RE	
PHINT CODE			c =	- INCLUDES ALL PRINTS INDI	CATED (	ON DOC	UMENT				INT	ERE	ROCESSOR LINK			DMC11-Ø		
	10		<u>s</u> =	CONFIDENTIAL AUTHORIZED	D SIGNAT	TURE R	EQUIRED							211	EET 3	OF3 B DD	1 `	

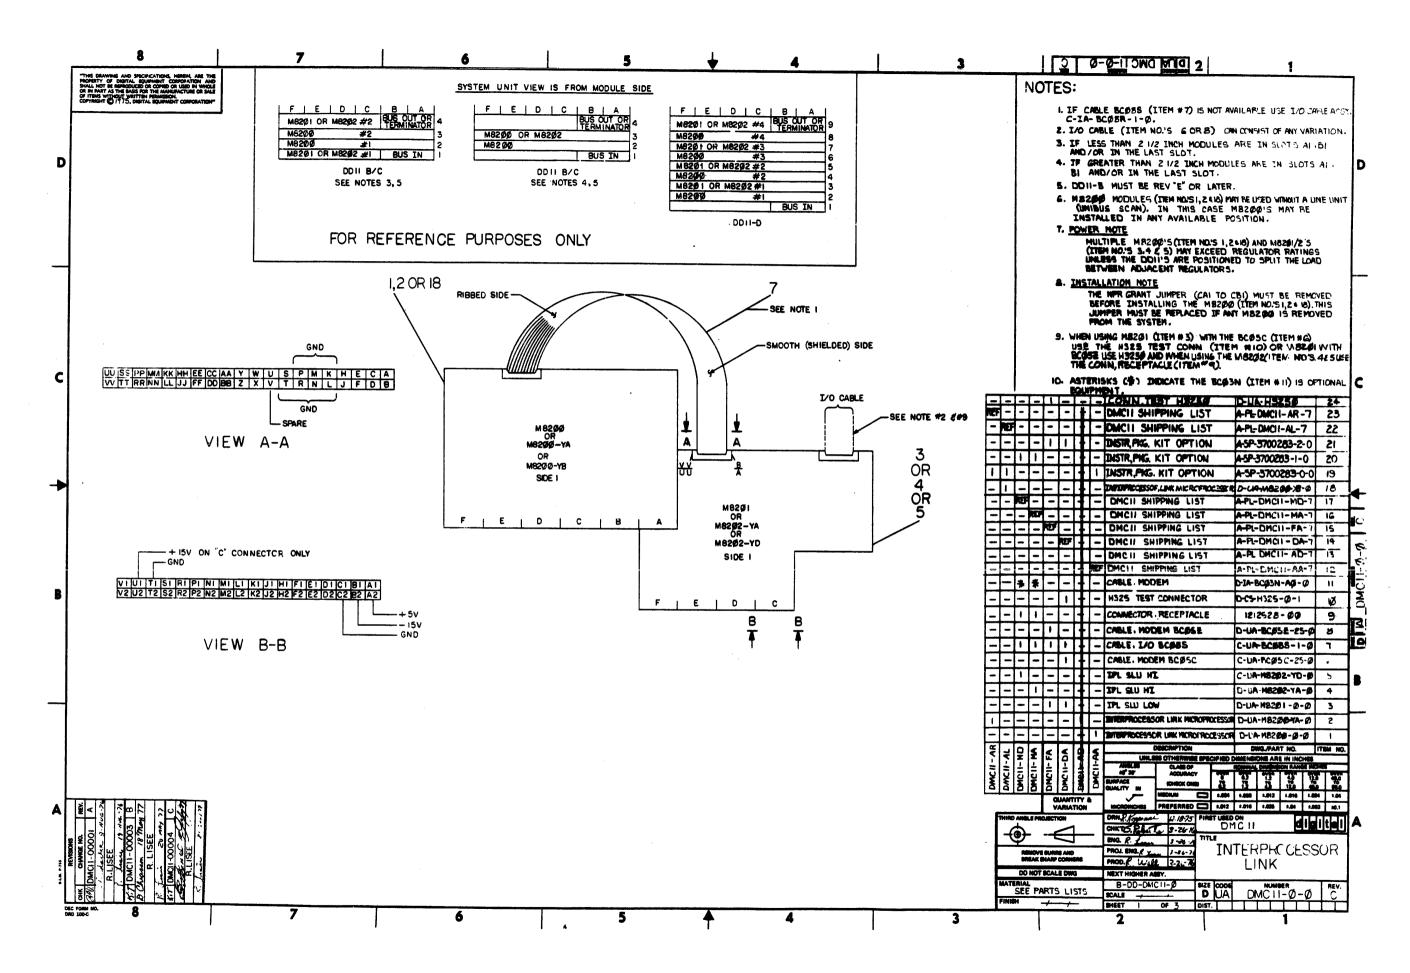


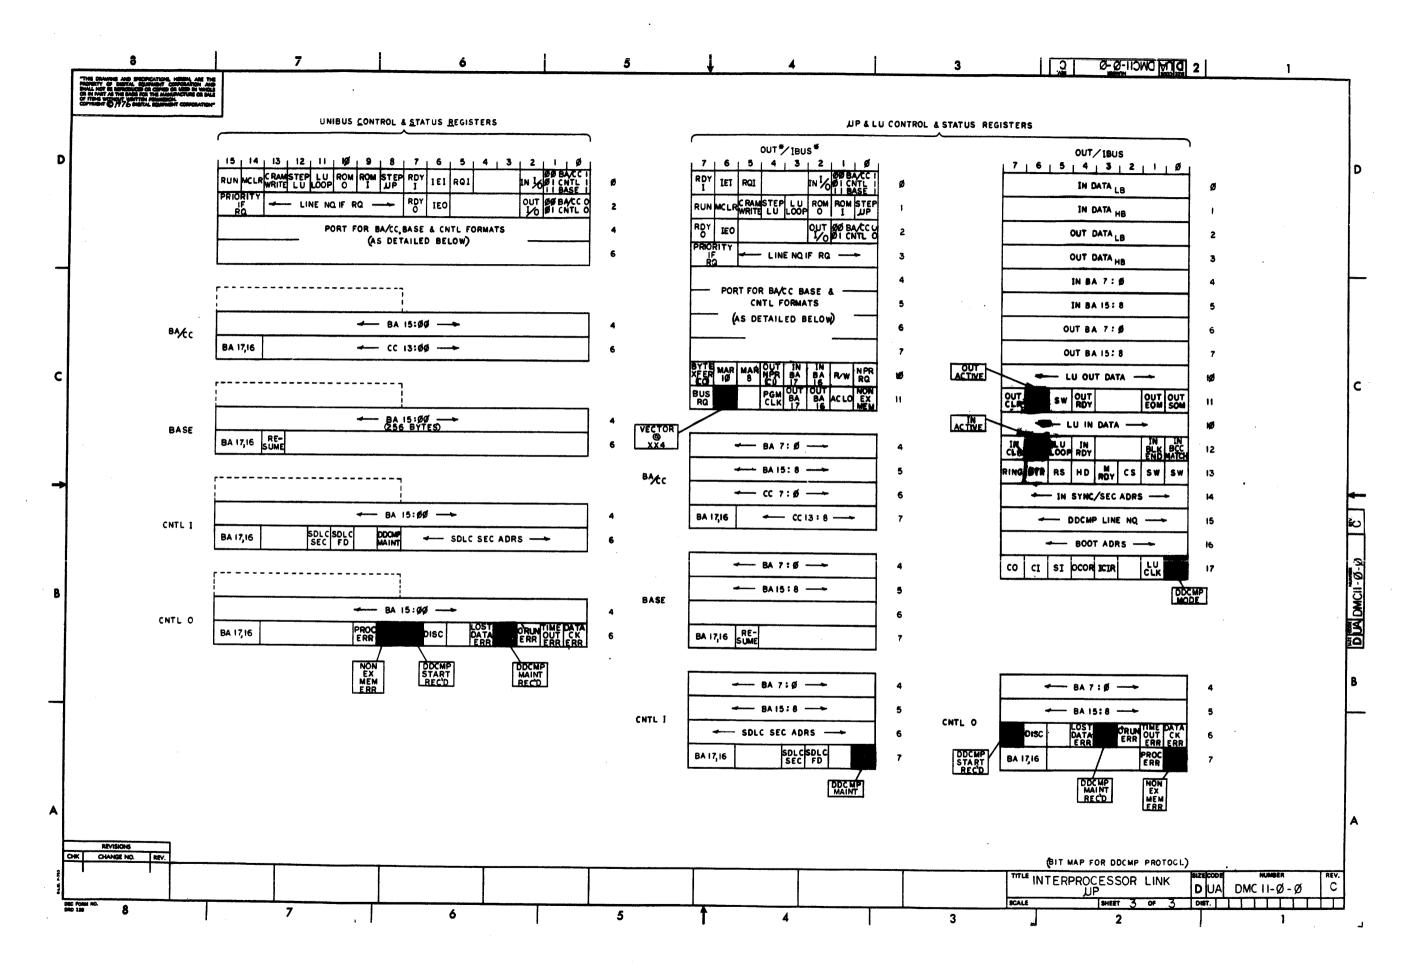


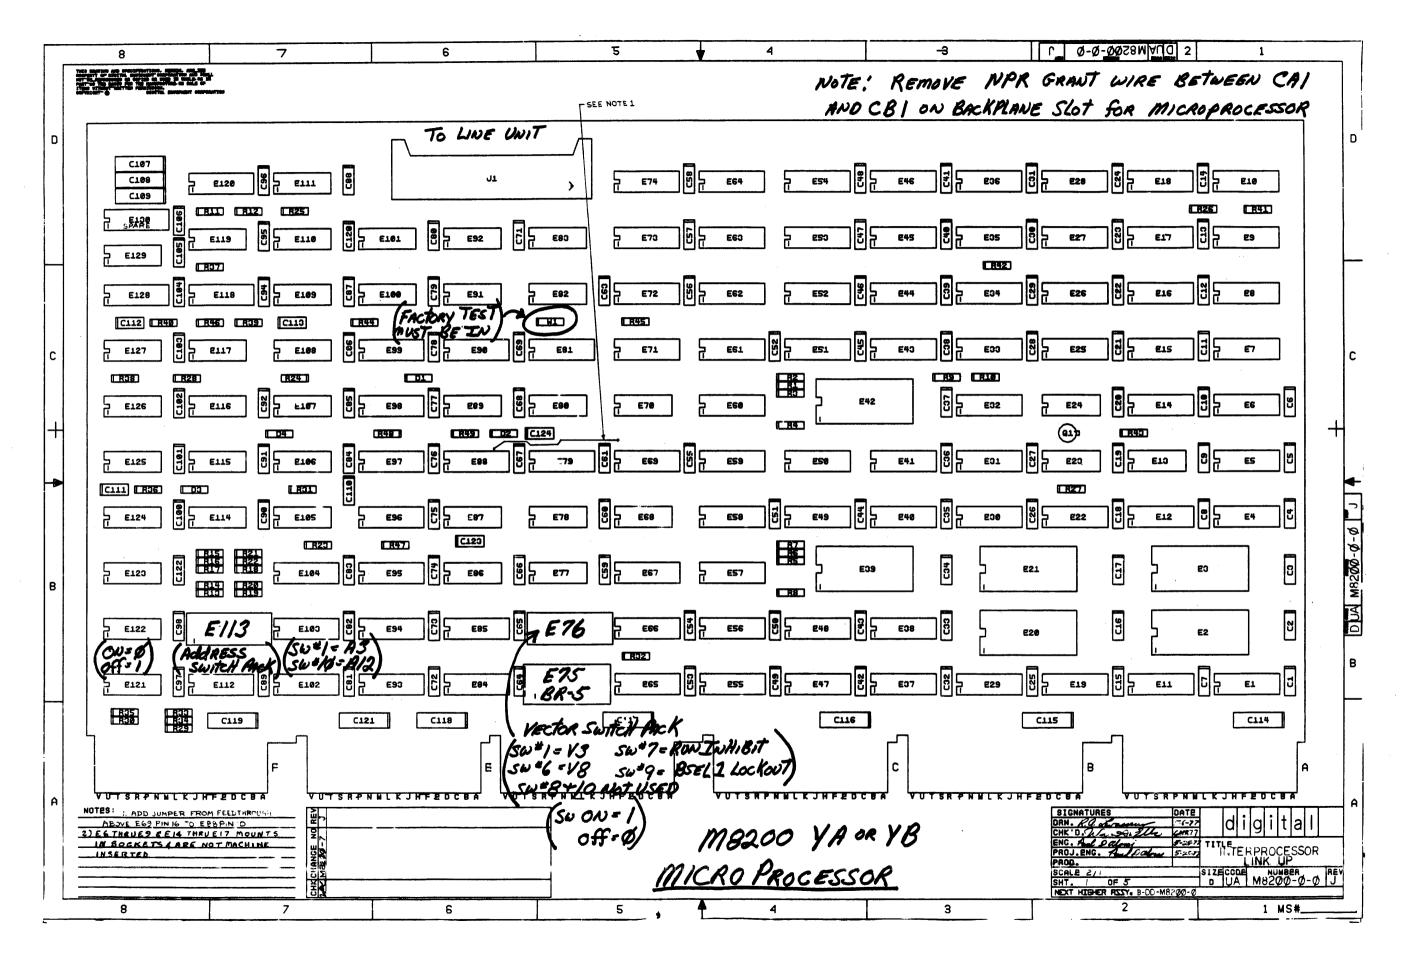


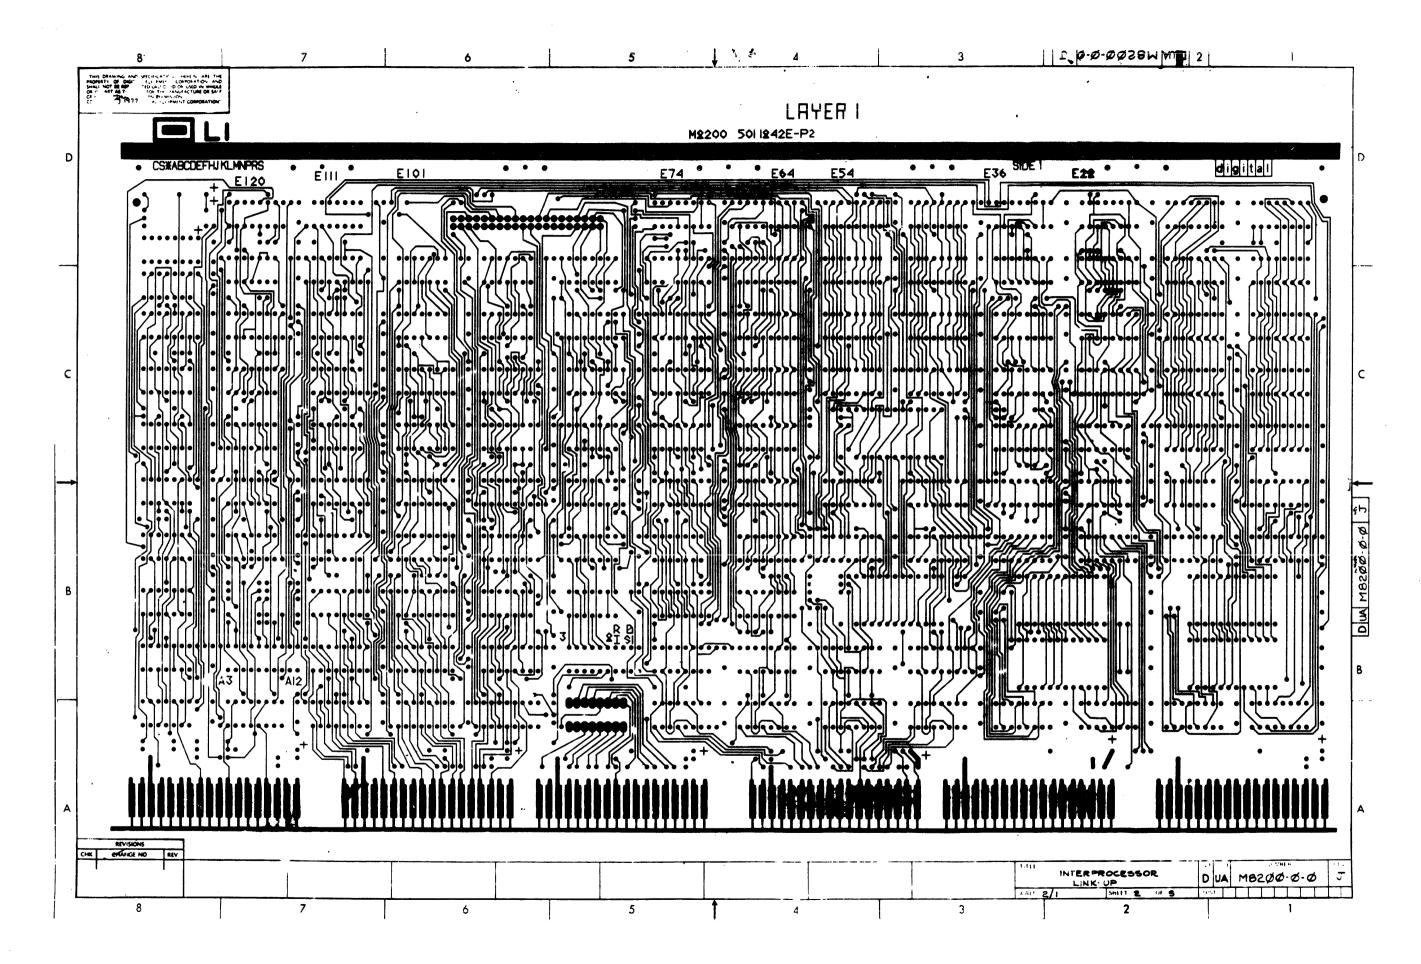


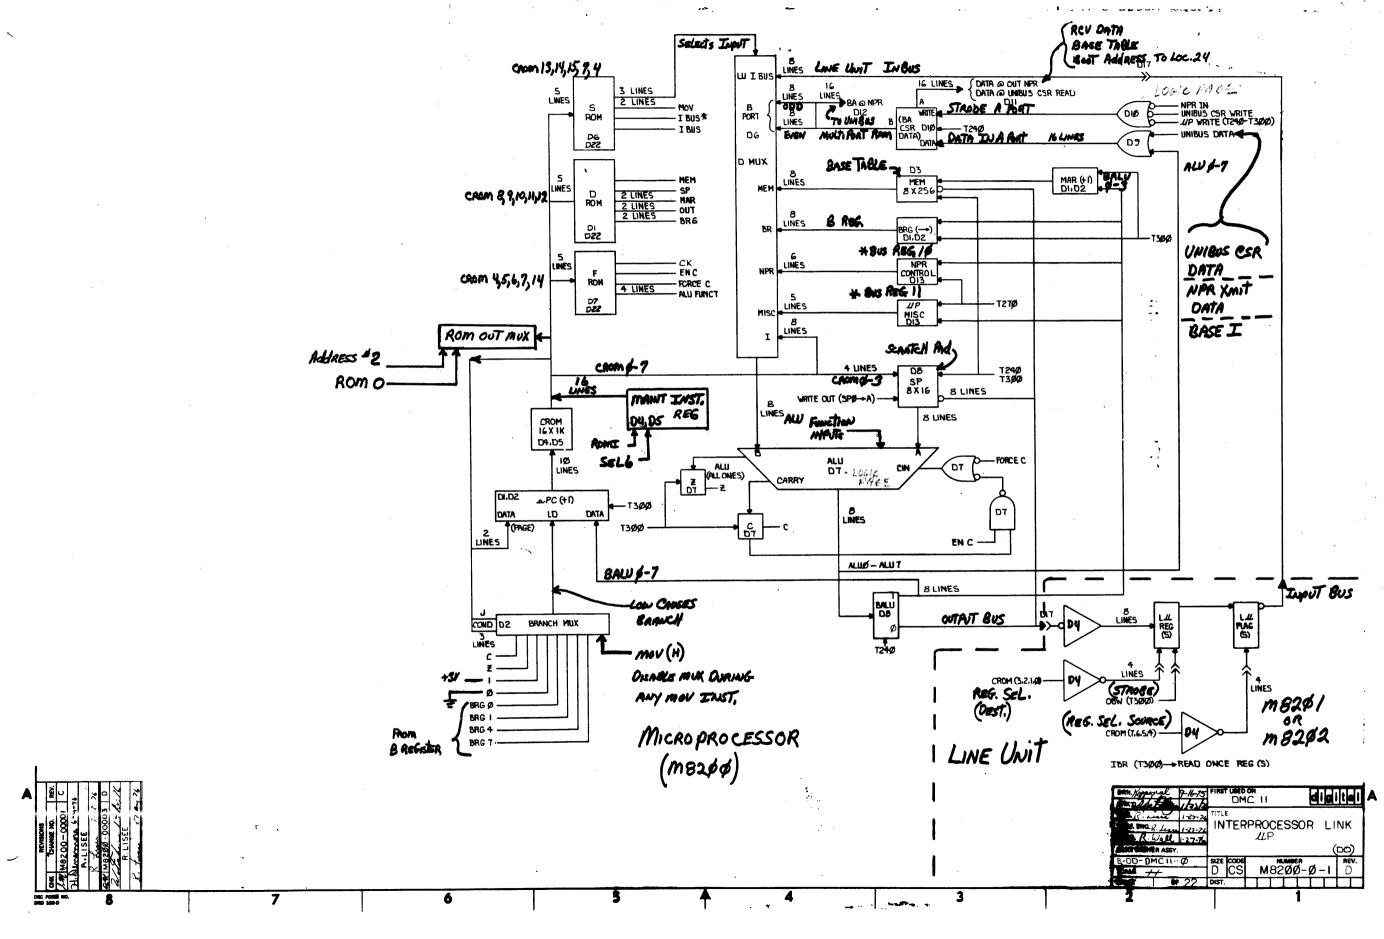


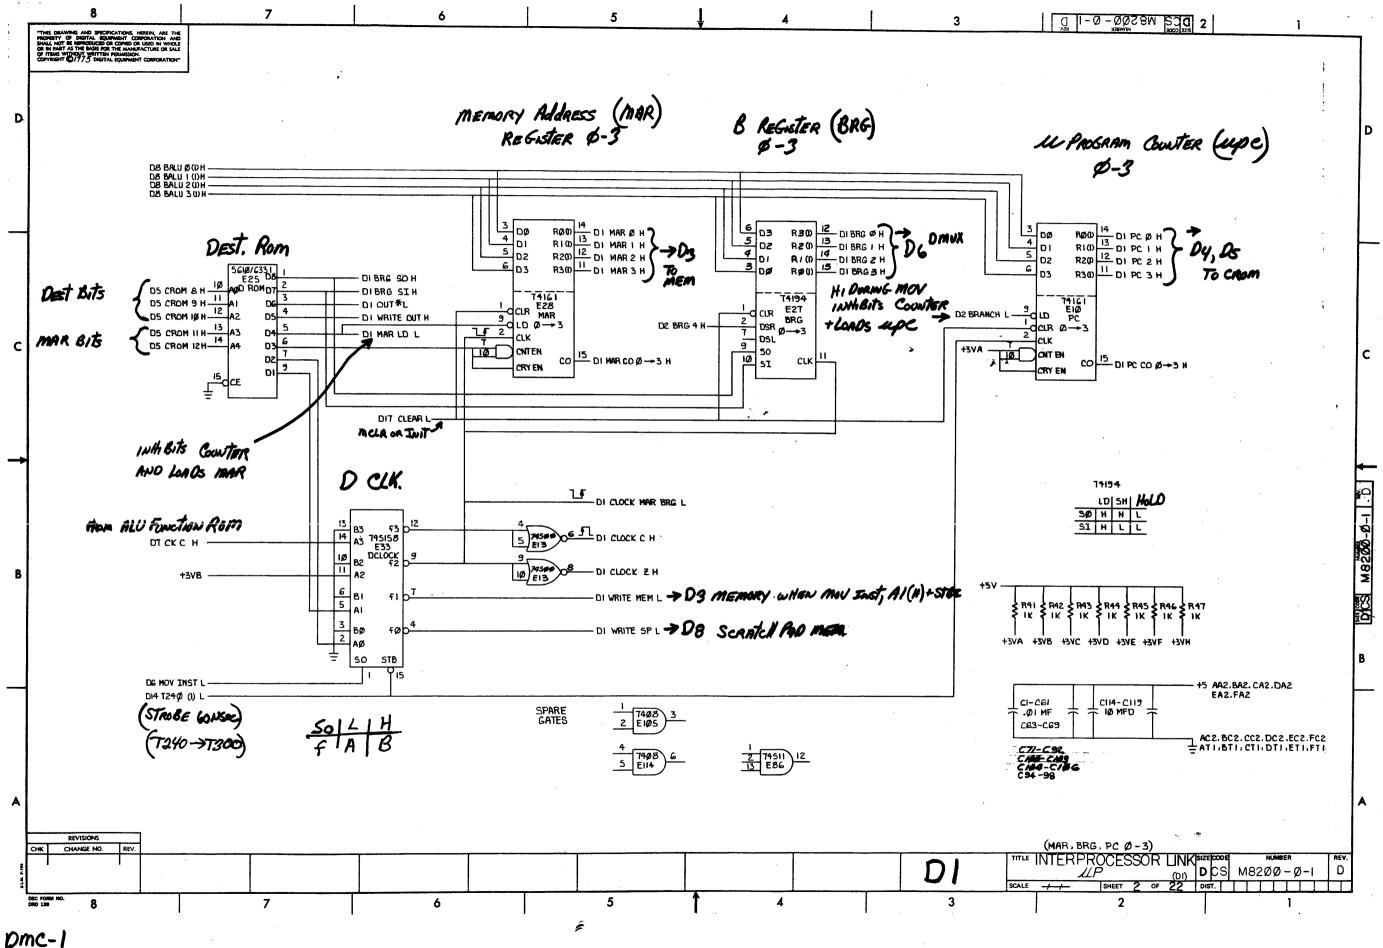


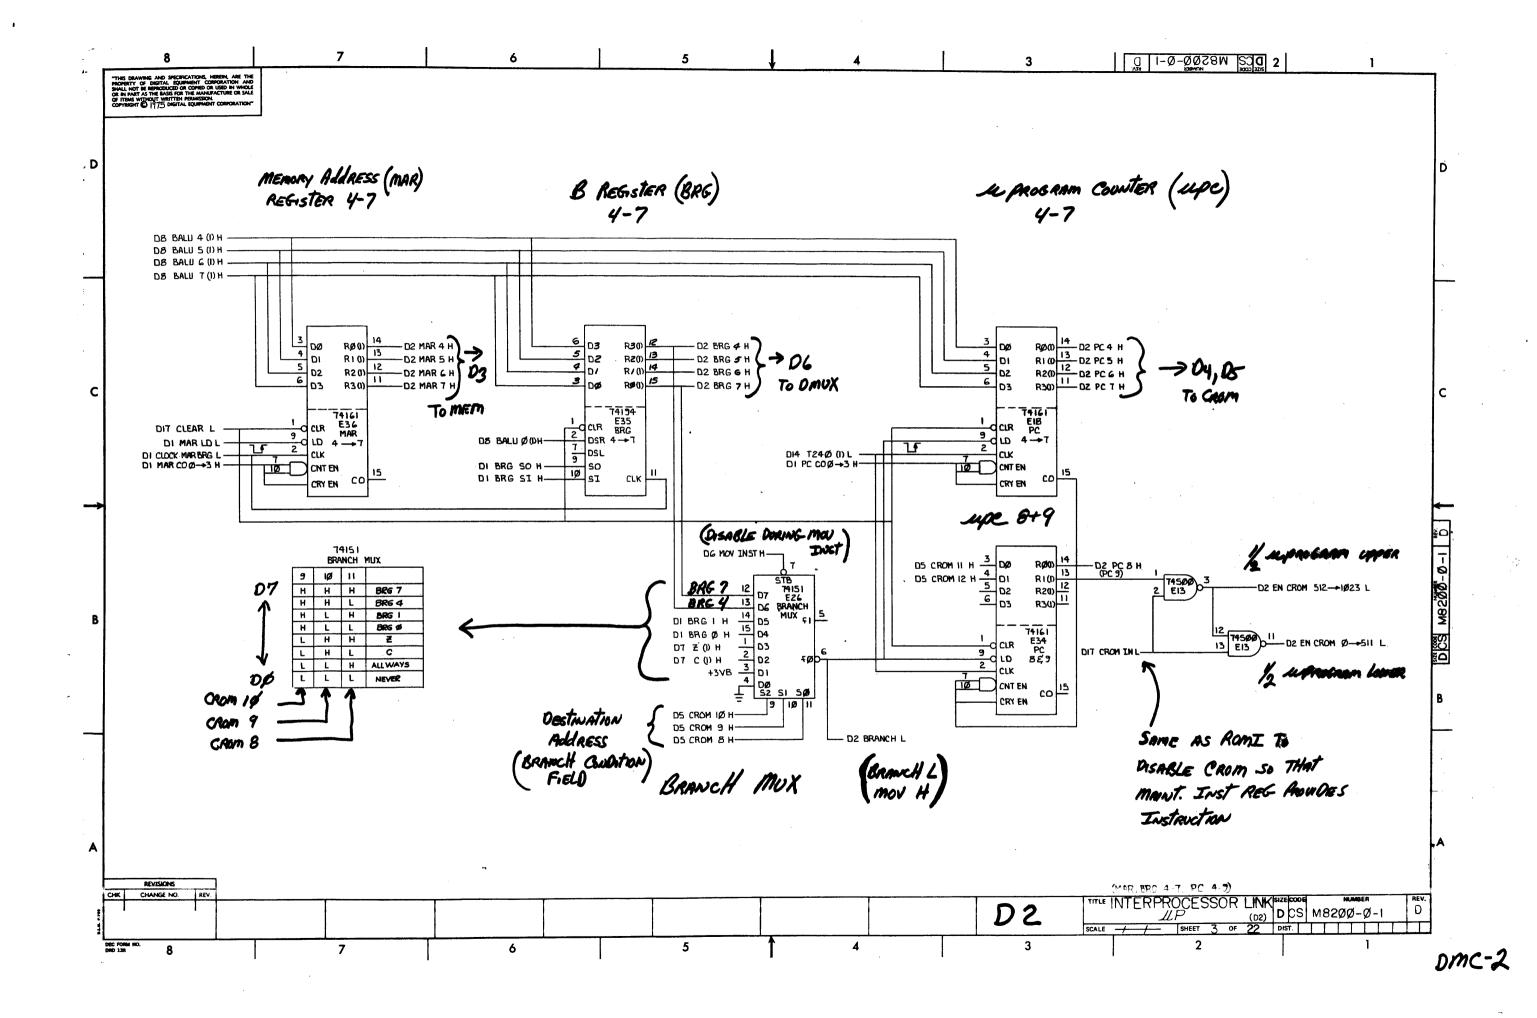


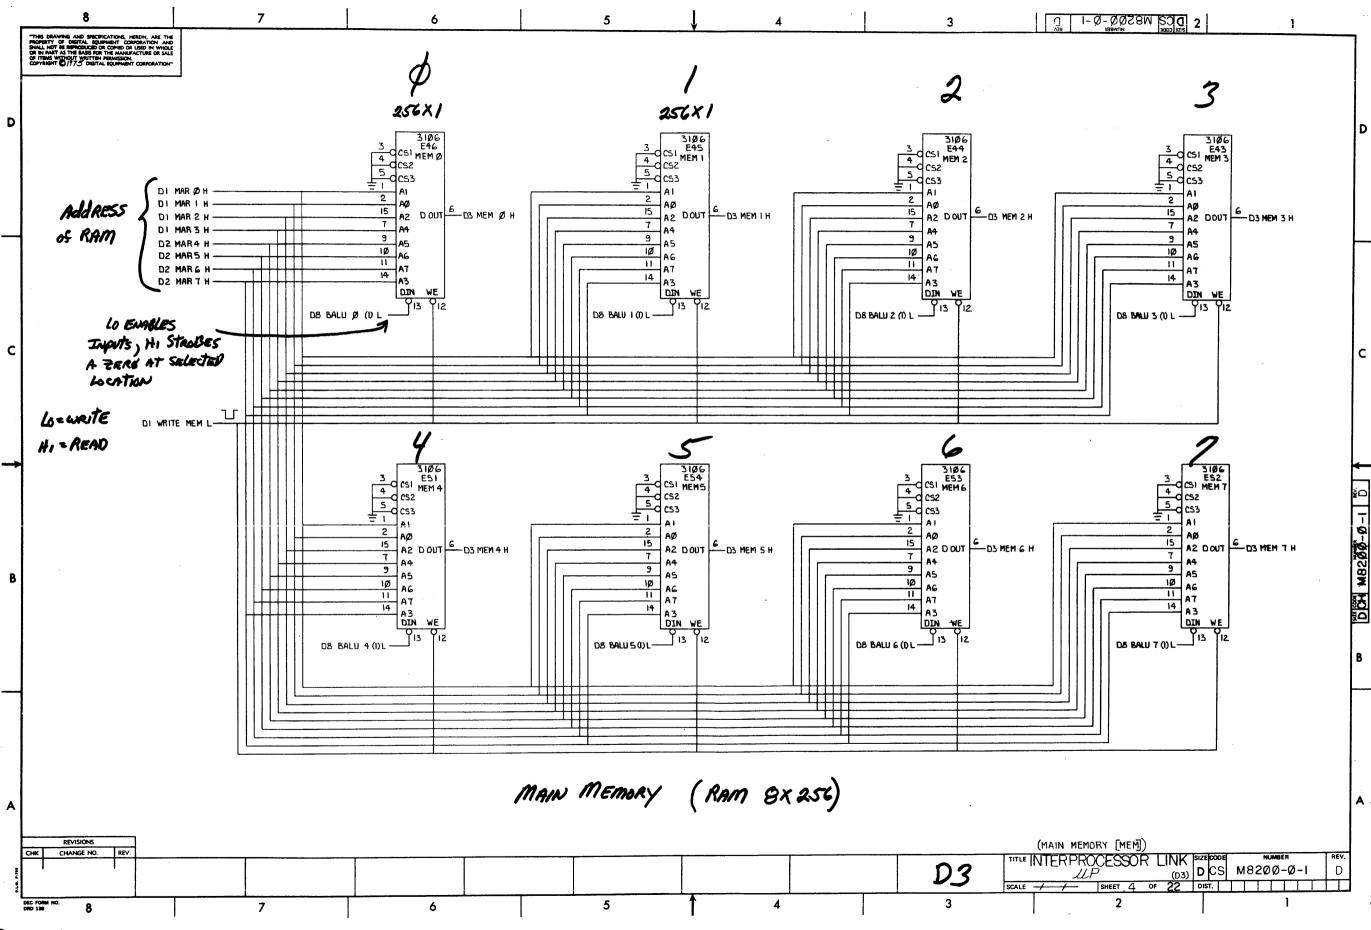


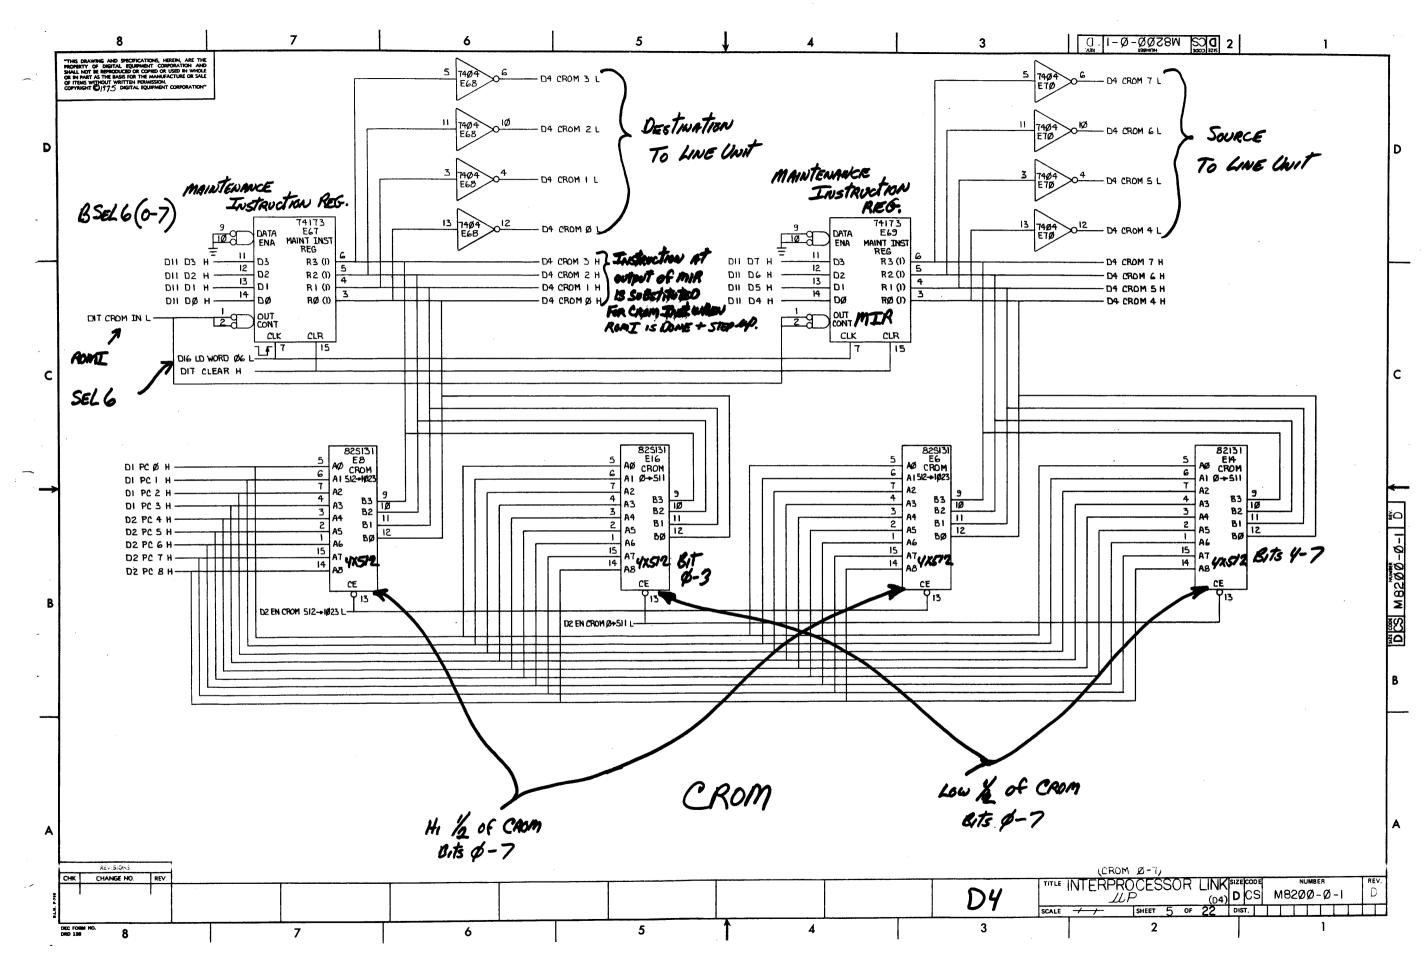


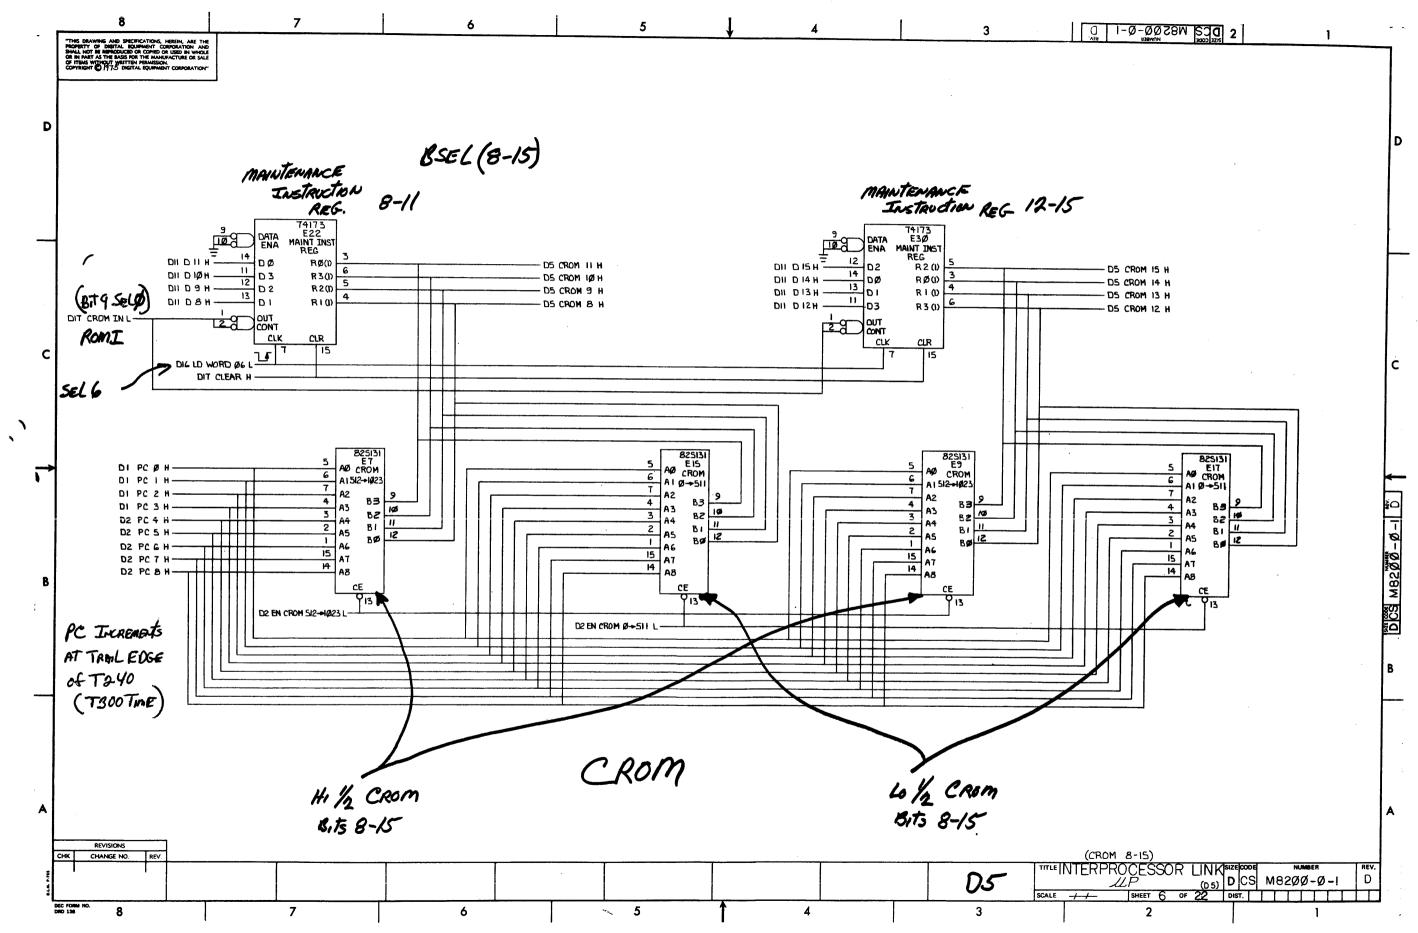


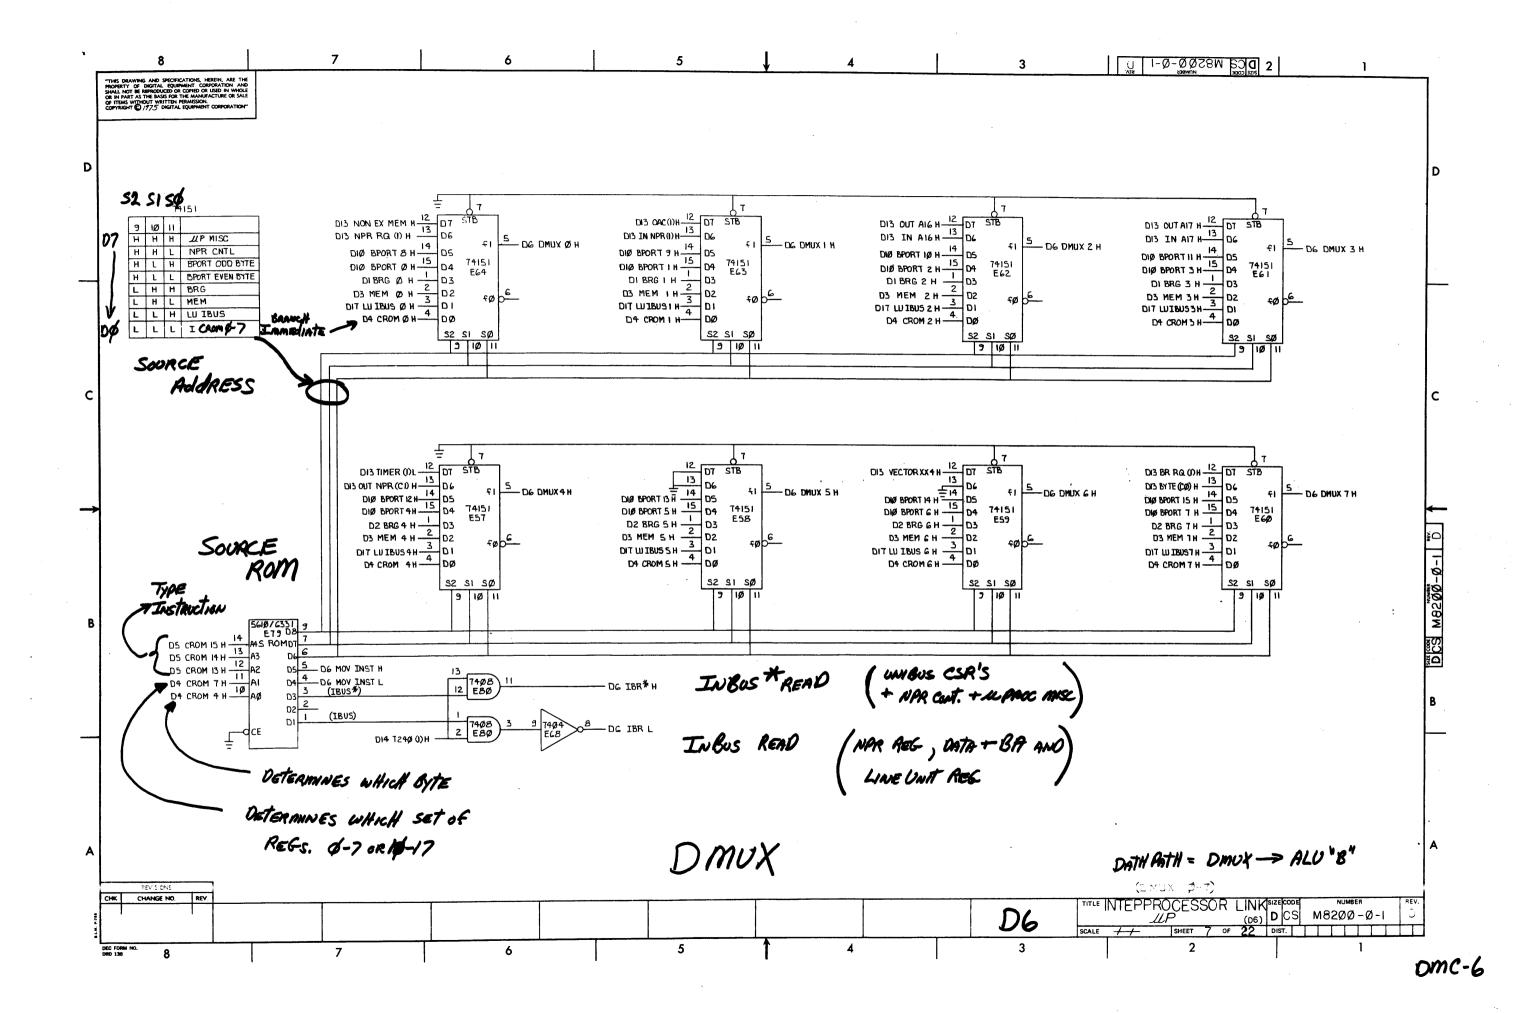


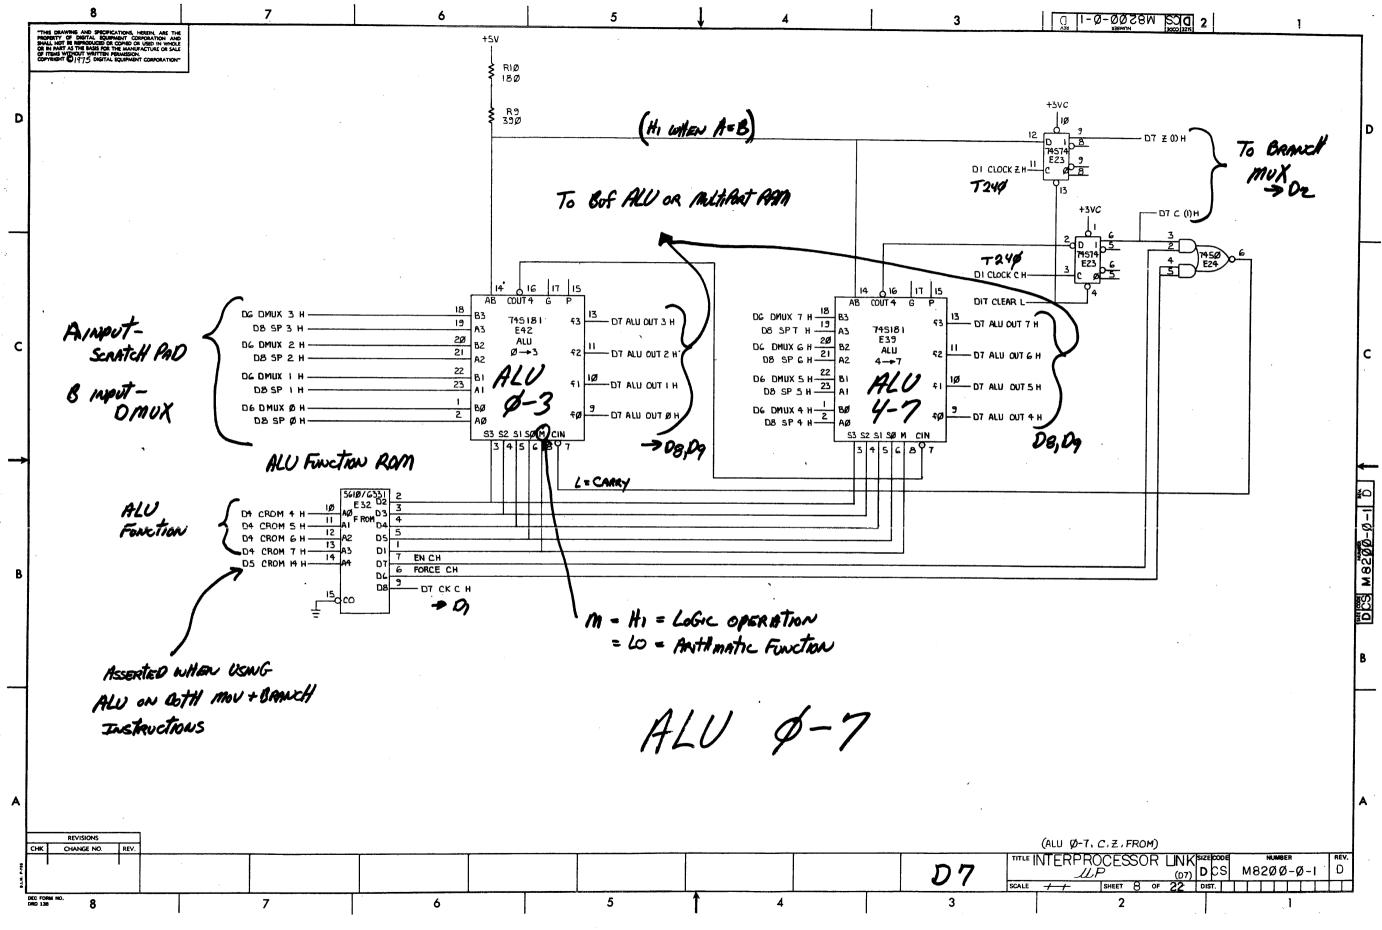


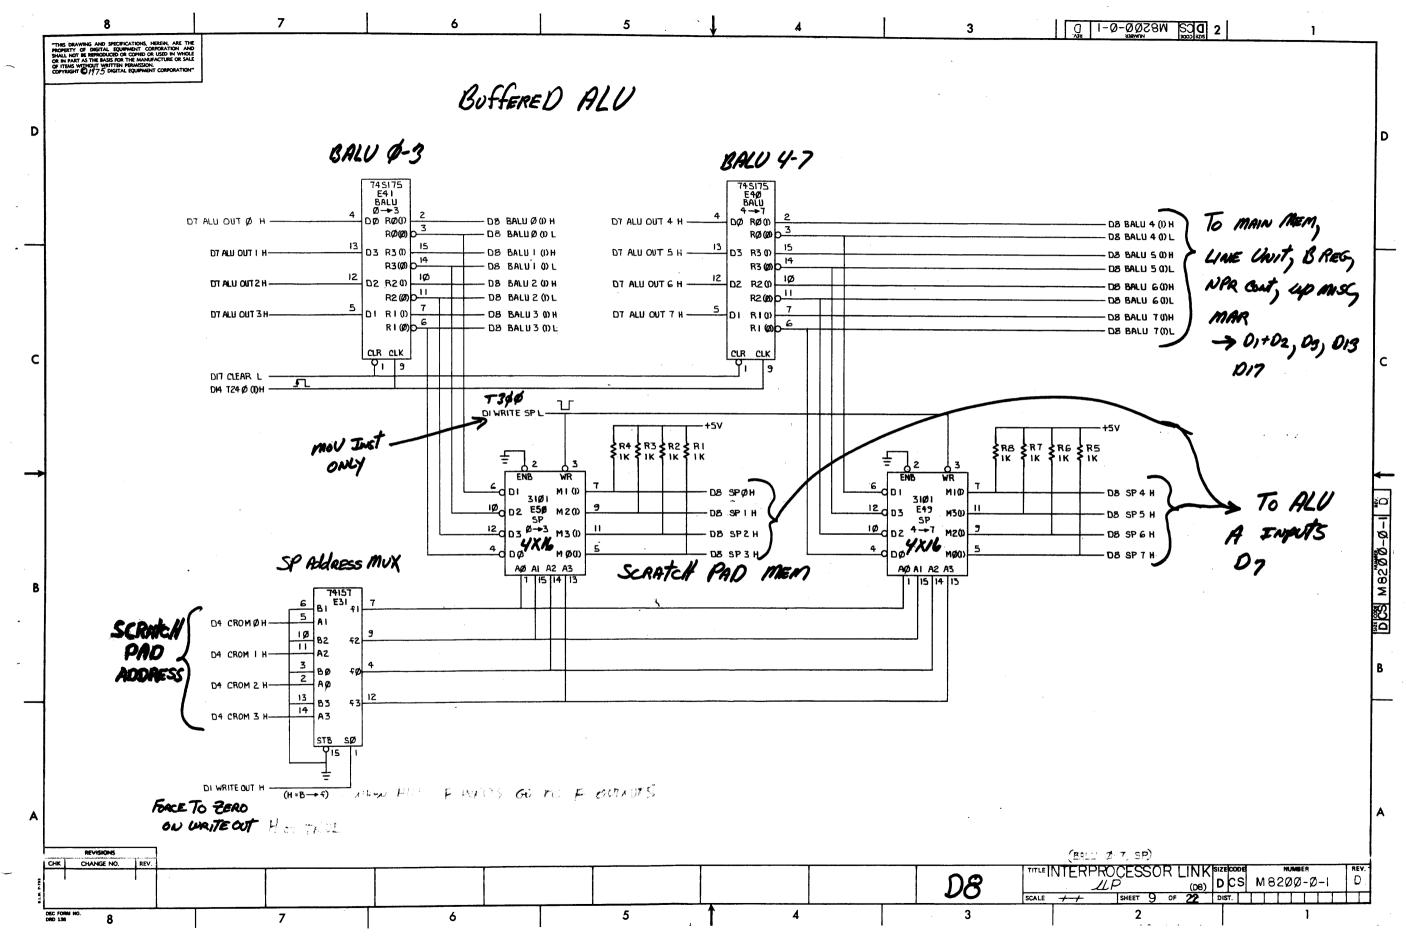


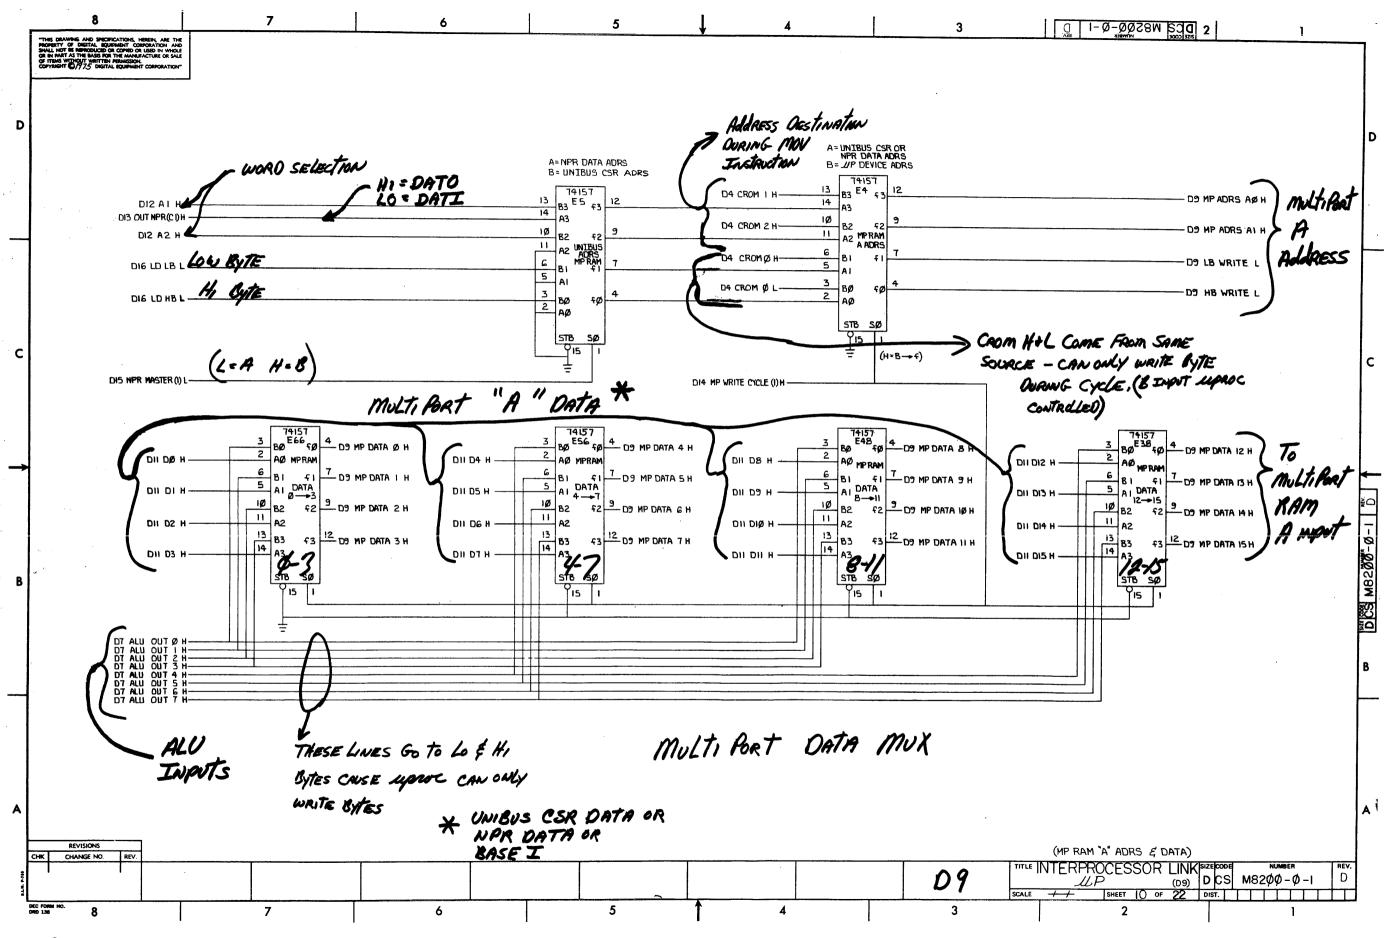


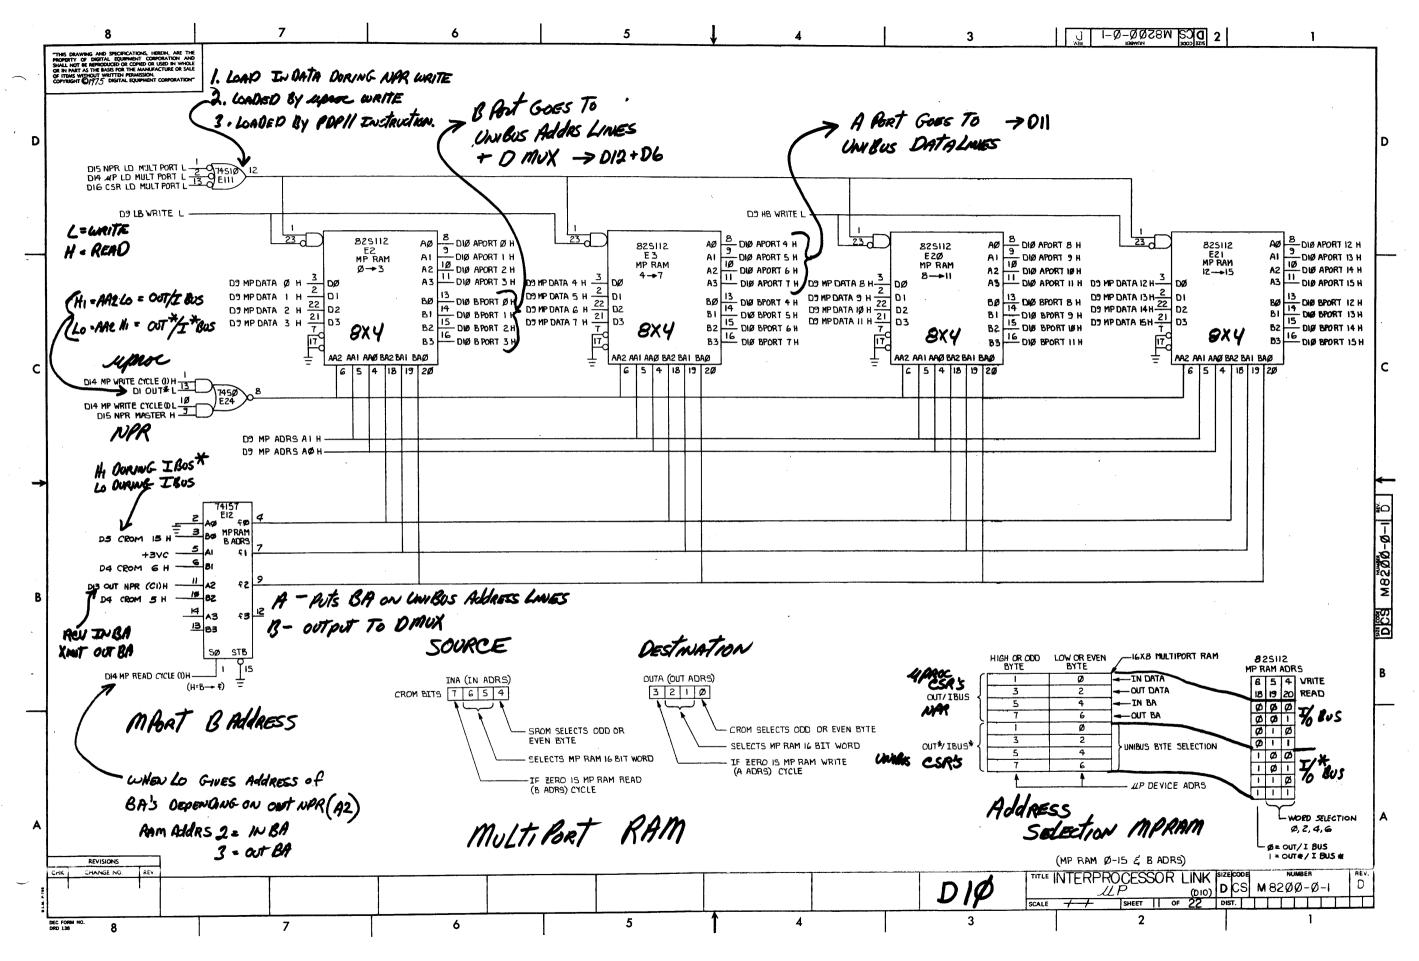


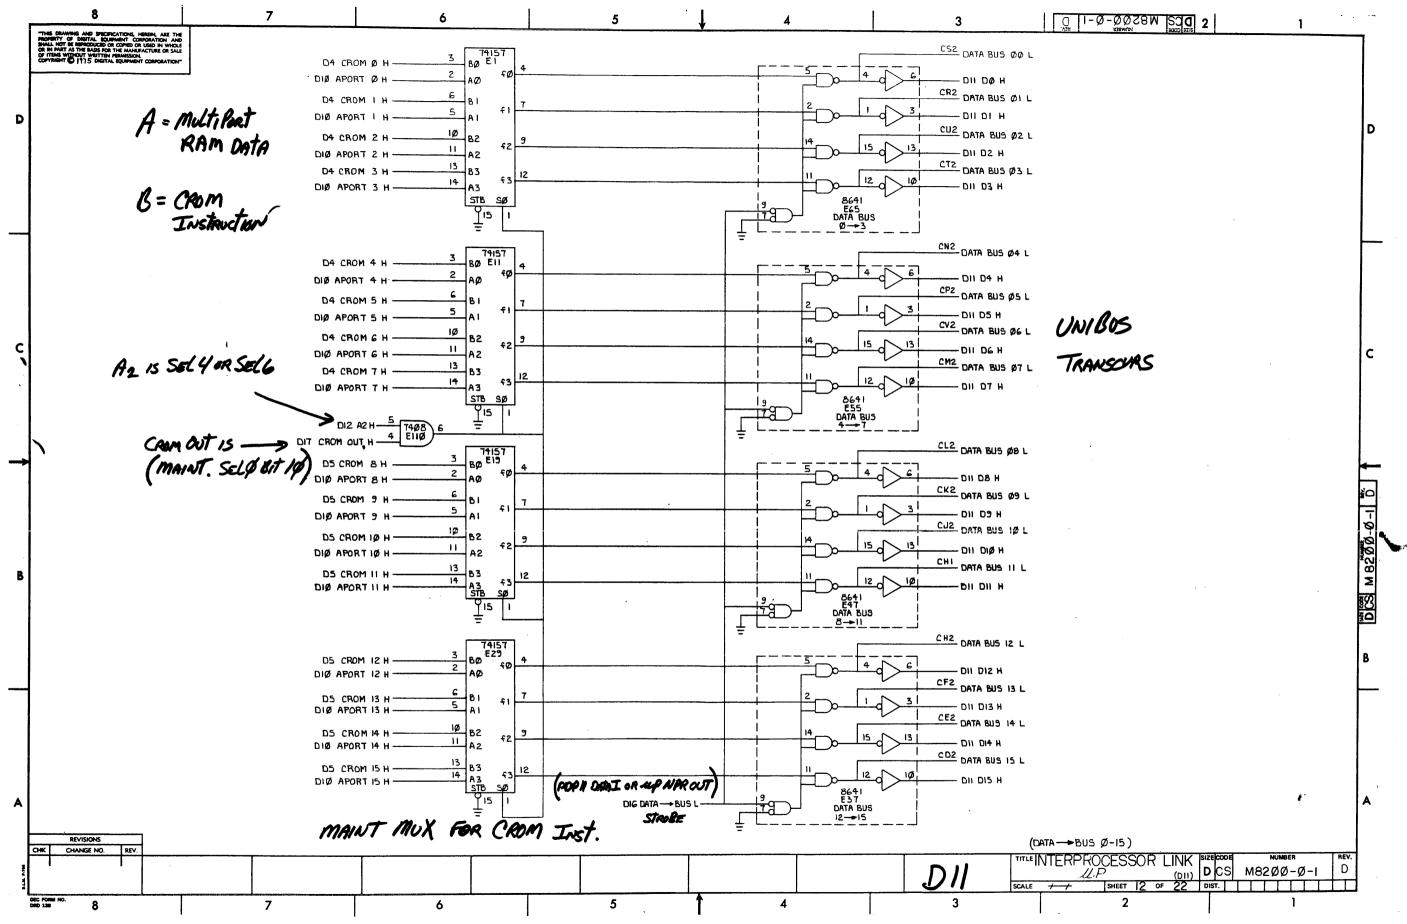


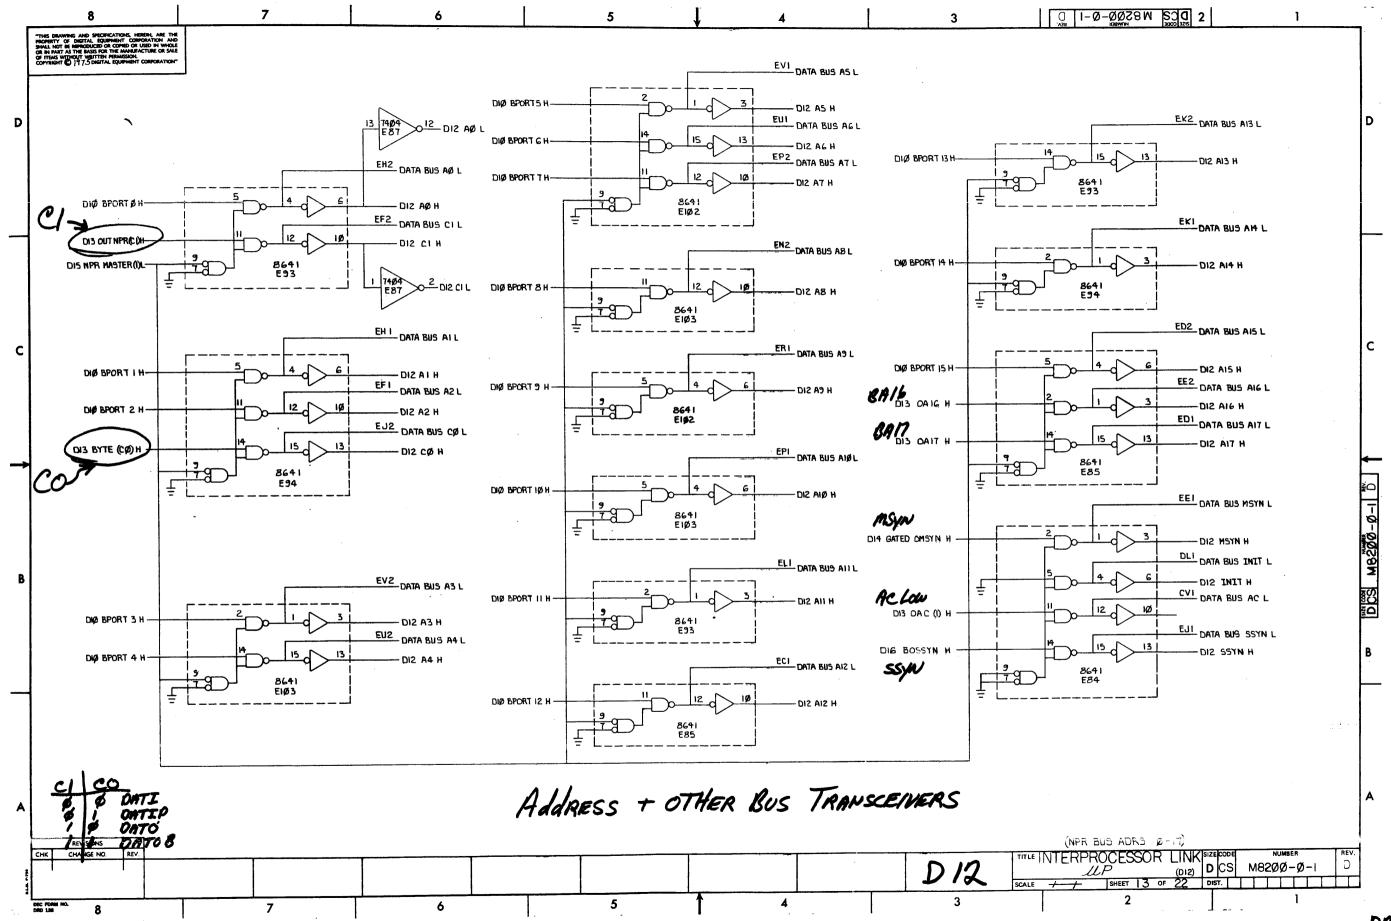


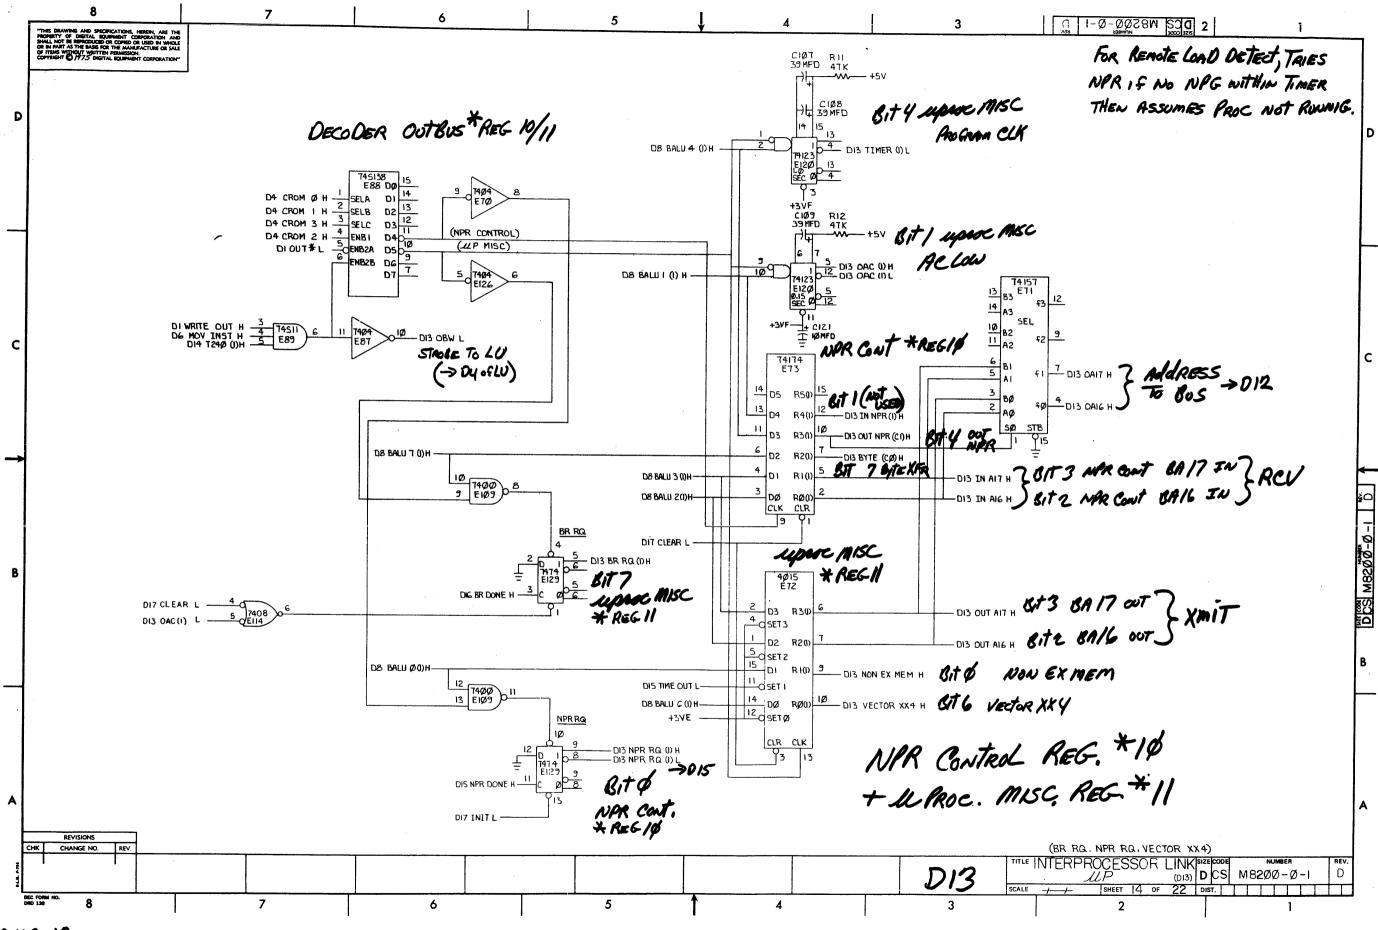


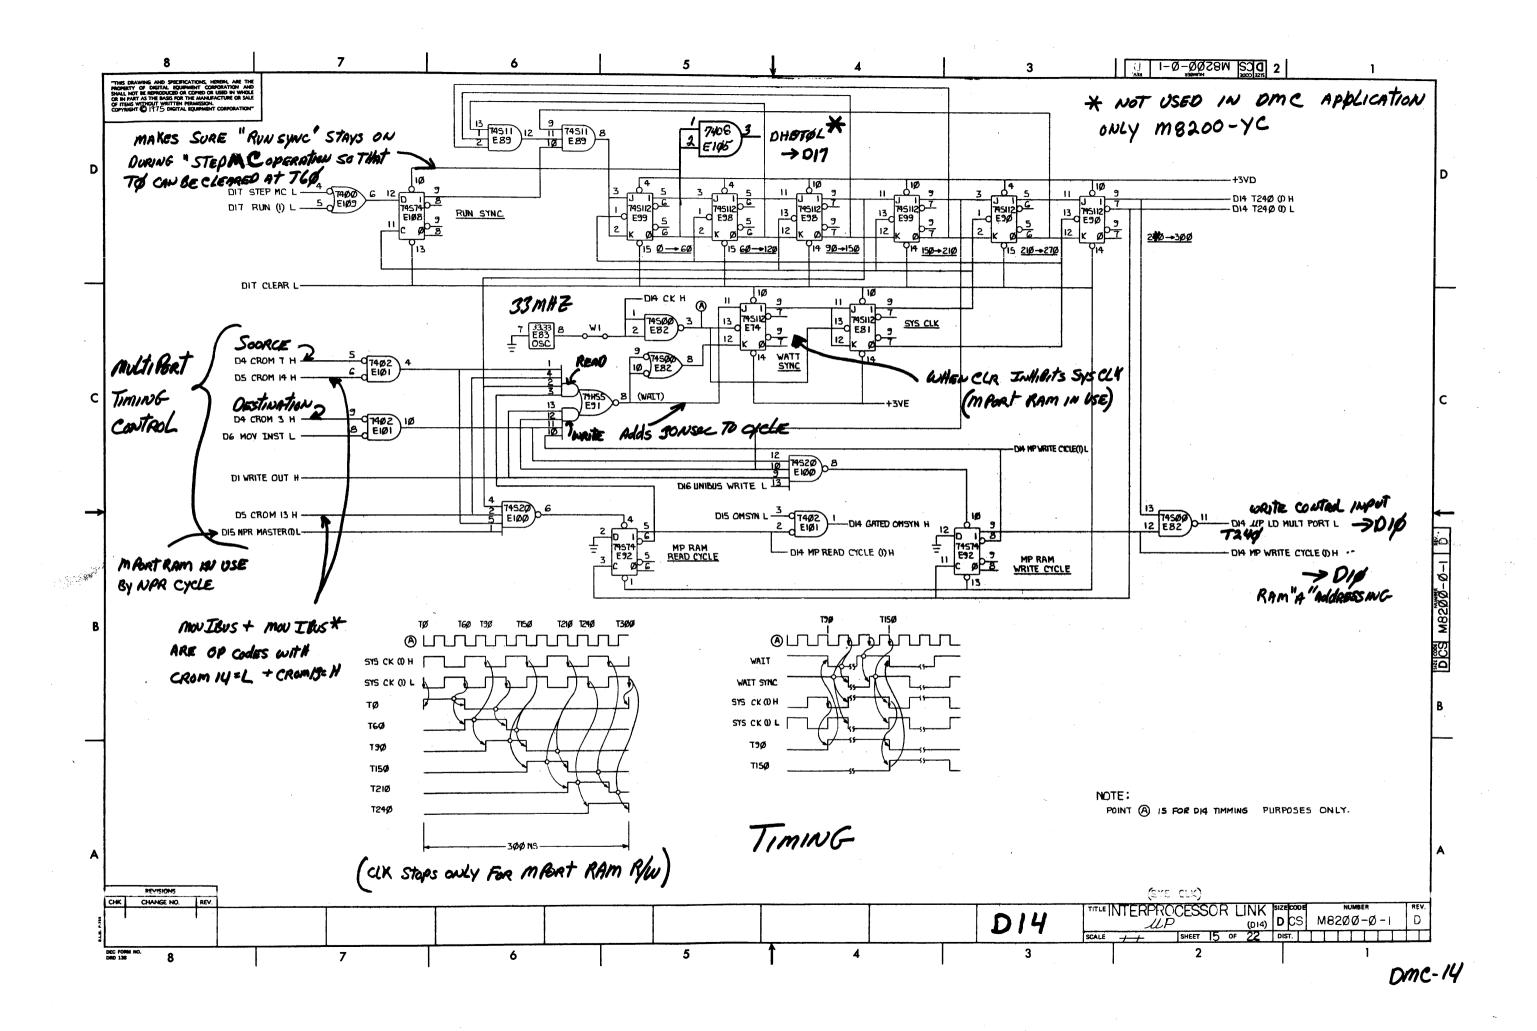

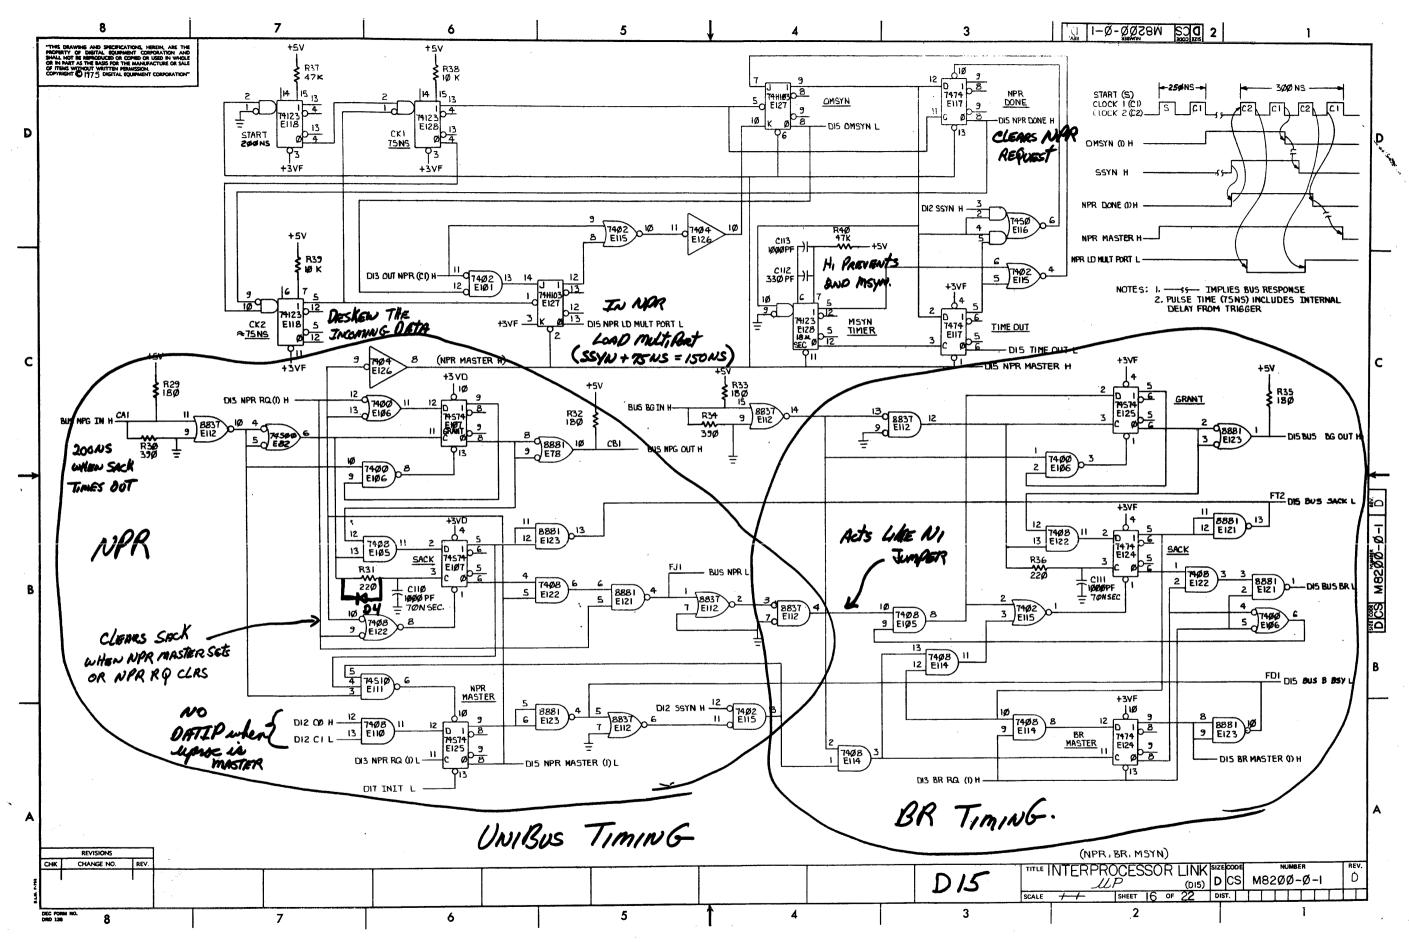


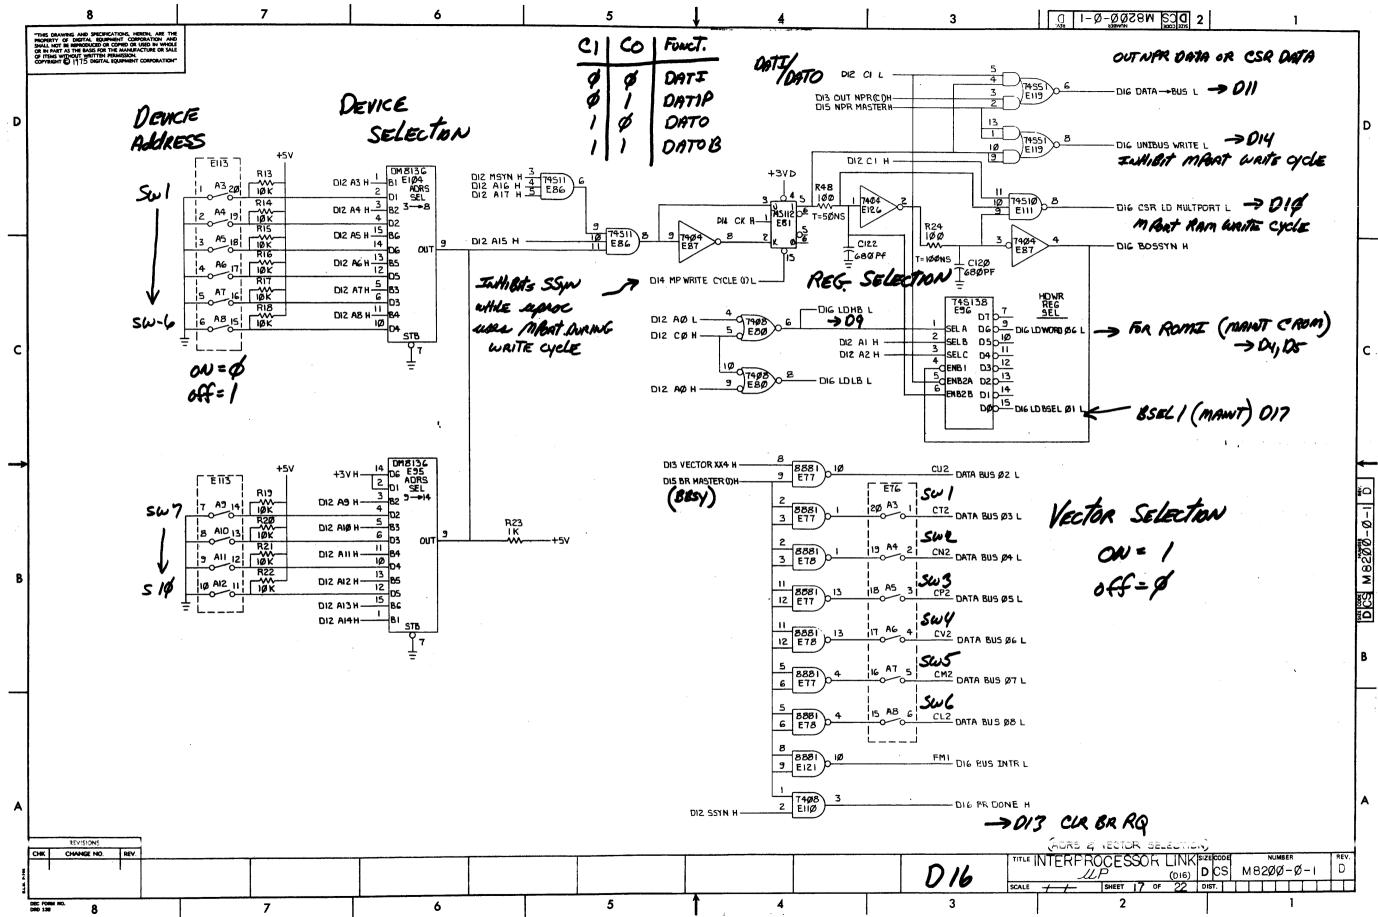

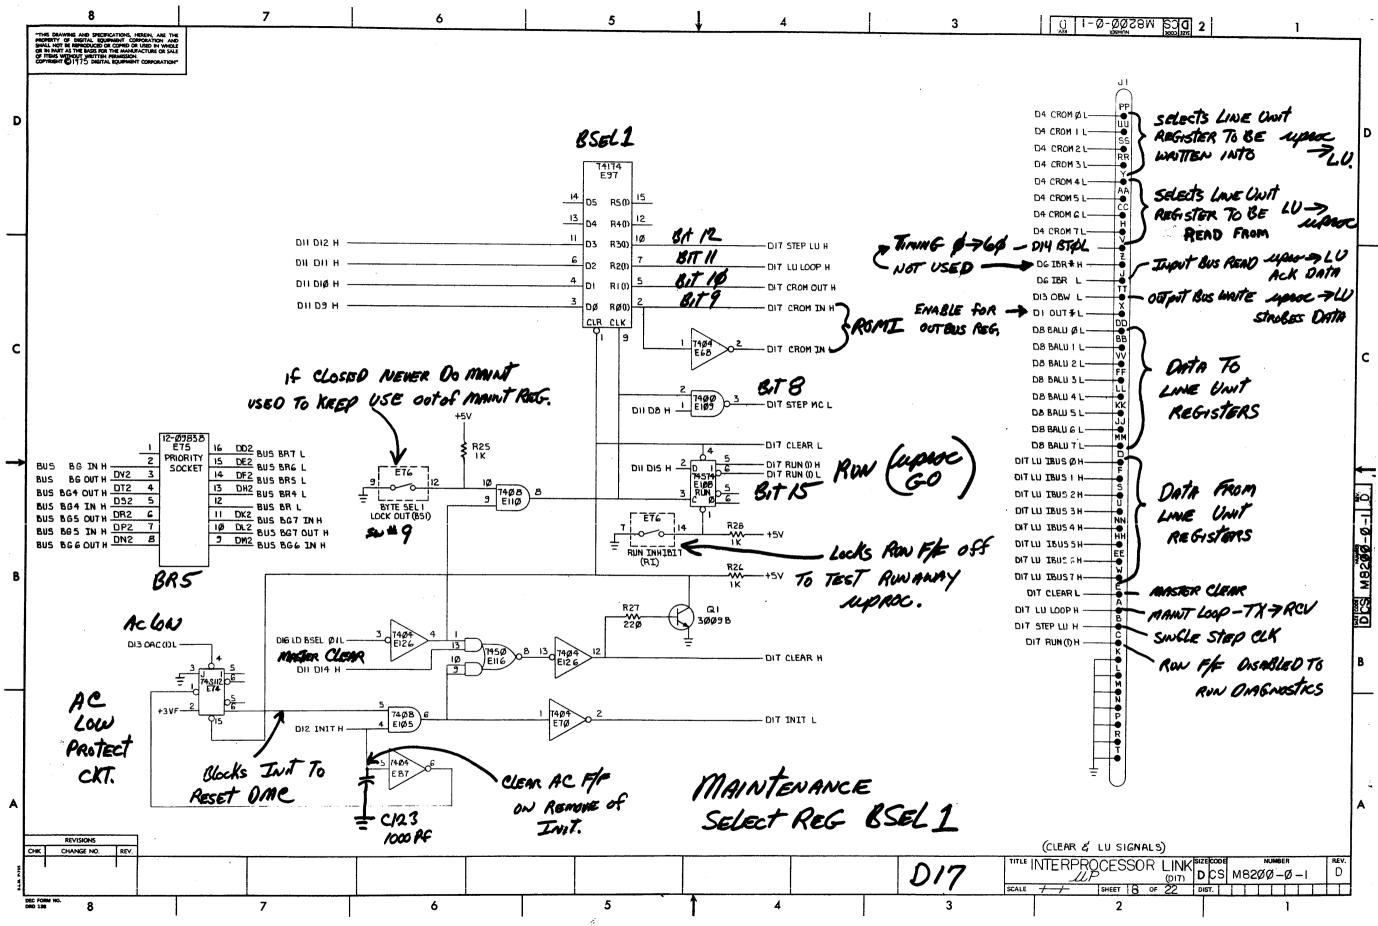


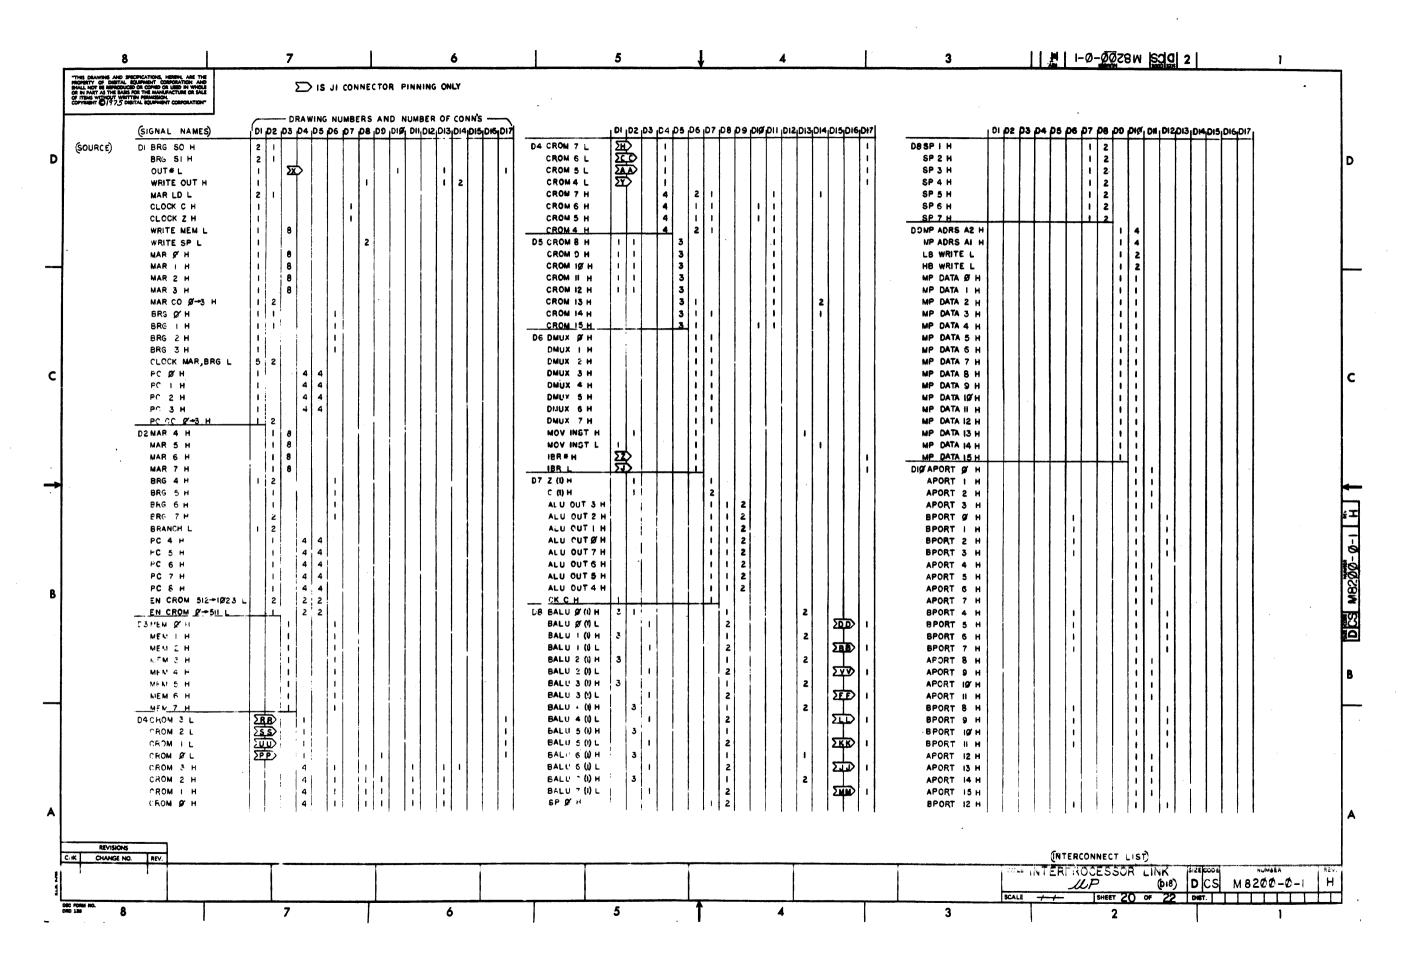


	8		7	,	6	5	1	4	3	H 1-0-0028W SQC 2
	"THIS DRAWING AND S PROPERTY OF DISTAL SHALL NOT BE REPRODUC OR IN PART AS THE BASE OF THIS WITHOUT WEEL COPYRIGHT © 1/97.5 D	PECFICATIONS, HEREN, ARE THE SQUIMMENT CORPORATION AND CAD OR COMPOS OR WEST ON WHOLE IF FOR THE MANUFACTURE OR SALE TITEN PERMISSION.	;	∑ IS JI CONNEC	TOR PINNING ONLY					
		(SIGNAL NAMES)			ND NUMBER OF CONN'S		DI iD2 iD3 iD4 iD5 iD6	,D7 ,D8 ,D9 ,D19,D11 ,D12,D13,D14,D	15 <sub>1</sub> D16 <sub>1</sub> D17]	
D	(SOURCE)	DIØ BPORT 13 H BPORT 14 H				DI2 A7 H DATA BUS A8 L	EN2	1 2	I DIS BUS NPR L NPR MASTER (I) L	FJ1 3 3 D
		BPORT 15 H	. CS2		2 1	A8 H Data Bus A9 L	ERI	2	I OMSYN L	
		DØH DATA BUS ØI L DIH	. CR2		2	A9 H DATA BUS AKO/L AKO/H	EPI		TIME OUT L NPR MASTER H BUS BG OUT H	
		DATA BUS Ø2 L D 2 H			2	DATA BUS AN L	ELI	2 1	BUS SACK L  I BUS BR L	FT2
		DATA BUS Ø3 L D 3 H Data bus Ø4 L		1	2   1	DATA BUS AIZ L	ECI		BR MASTER (I) H	FDI 4 3 16
		D 4 H DATA BUS Ø5 L		1	2	DATA BUS AI3 L AI3 H DATA BUS AI4 L	EK2		DIG LD HB L LD LB L DATA BUS L	
		D 5 H Data Bus Ø6 L	. CV2 1	1	2 1	A14 H DATA BUS A15 L	ED2	1 2	I UNIBUS WRITE L CSR LD MULT PORT	
		D 6 H DATA BUS Ø7 L D 7 H	CM2		2	AI5 H DATA BUS AI6 L AI6 H	EE2		BOSSYN H LD WORD Ø6 L LD BSEL Ø1 L	
С		DATA BUS Ø8 L D 8 H		1	2 1 1 1	DATA BUS AIT L	EDI	2	BUS INTR L BR DONE H	FM1
		DATA BUS Ø9 L D 9 H DATA BUS IØ L			2 1 2	DATA BUS MSYN L MSYN H DATA BUS INIT L	EEI	2 1	DI7 STEP LU H LU LOOP H	<b>温</b> シ 2 2 2
		DIØH DATA BUS II L			1 1	INIT H DATA BUS AC L	CVI	1 2 1 2	CROM OUT H CROM IN H CROM IN L	
		D II H DATA BUS 12 L	CH2		1 2	CATA BUS SSYN L SSYN H	EUI	2	CLEAR L RUN(I) H	3 4 \( \overline{\Sigma} \)
<b>†</b>		DIZH DATA BUS 13 L DI3H	CF2		2	DI3 OBW L BR RQ (I) H NPR RQ (I) H			RUN(I) L CLEAR H INIT L	
		DATA BUS 14 L			2	NPR RQ(I) L Timer (I) L			LU IBUS Ø H	ND
		DATA BUS 15 L	CDS	4 4 4	2	OAC (I) H IN NPR (I) H OUT NPR (CI) H			LU IBUS 2 H	
В		DATA BUS AØ L	EH2		2 1	BYTE (CØ) H NON EX MEM H			LU 18US 4 H LU 18US 5 H LU 18US 6 H	日 日 日 日 日 日 日 日 日 日 日 日 日 日 日 日 日 日 日
		DATA BUS CI L	EF2		2 1	VECTOR XX4 H OAI7 H			1 LU IBUS 7 H + 3 Va. R41	
		CI L DATA SUS AI L AI H	EHI			OAI6 H IN AI7 H IN AI6 H		2 2	+ 3Vb R42 + 3Vc R43 + 3Vd R44	
		DATA BUS A2 L 42 H			2 1 1	OUT AI7 H OUT AI6 H		2 2	+ 3% R45 + 3% R46	3 6 2 1 3 2 8 1 B
4		DATA BUS CØ L CØ H DATA BUS A3 L	i ! !		2 1 2	DI4 CK H GATFD OMSYN H MP READ CYCLE (I) H		1 1 2	1 + 3Vh R47 STEP MC L	
		∔3 H Data bus a4 L	i		1 1 2	MP WRITE CYCL" (I) L T2497 (I) H	2 2	2 1 2	DATA BUS NPG IN H BUS BG IN H DI3 OAC (DL	CA1 4 3 1
		A4 H DATA BUS A5 L A5 H	EVI			T24Ø (I) L UP LD MULT PORT L MP WRITE CYCLE (I) H	2	1 3		
İ		DATA BUS A6 L	EUI			'' l-	<del>v                                     </del>	5 1 1 2		
A		DATA BUS A7 L	EP2		2	BUS NPG OUT H	св/		s	A
ŀ	REVISIONS									
#	CH. CHANGE NO	D.   REV.	T						TITT	(INTERCONNECT LIST)  LE INTERPROCESSOR LINK SIZEDODE NUMBER REV.  LLP (DIS) D CS M 8 2 ØØ - Ø - I H
1	DEC PORM NO. DED 130 8	<u> </u>	7		6	5				LE + SHEET 2 OF 22 DIST.
- *	•	1.	•	ł	J	,	i	•	3	2 1

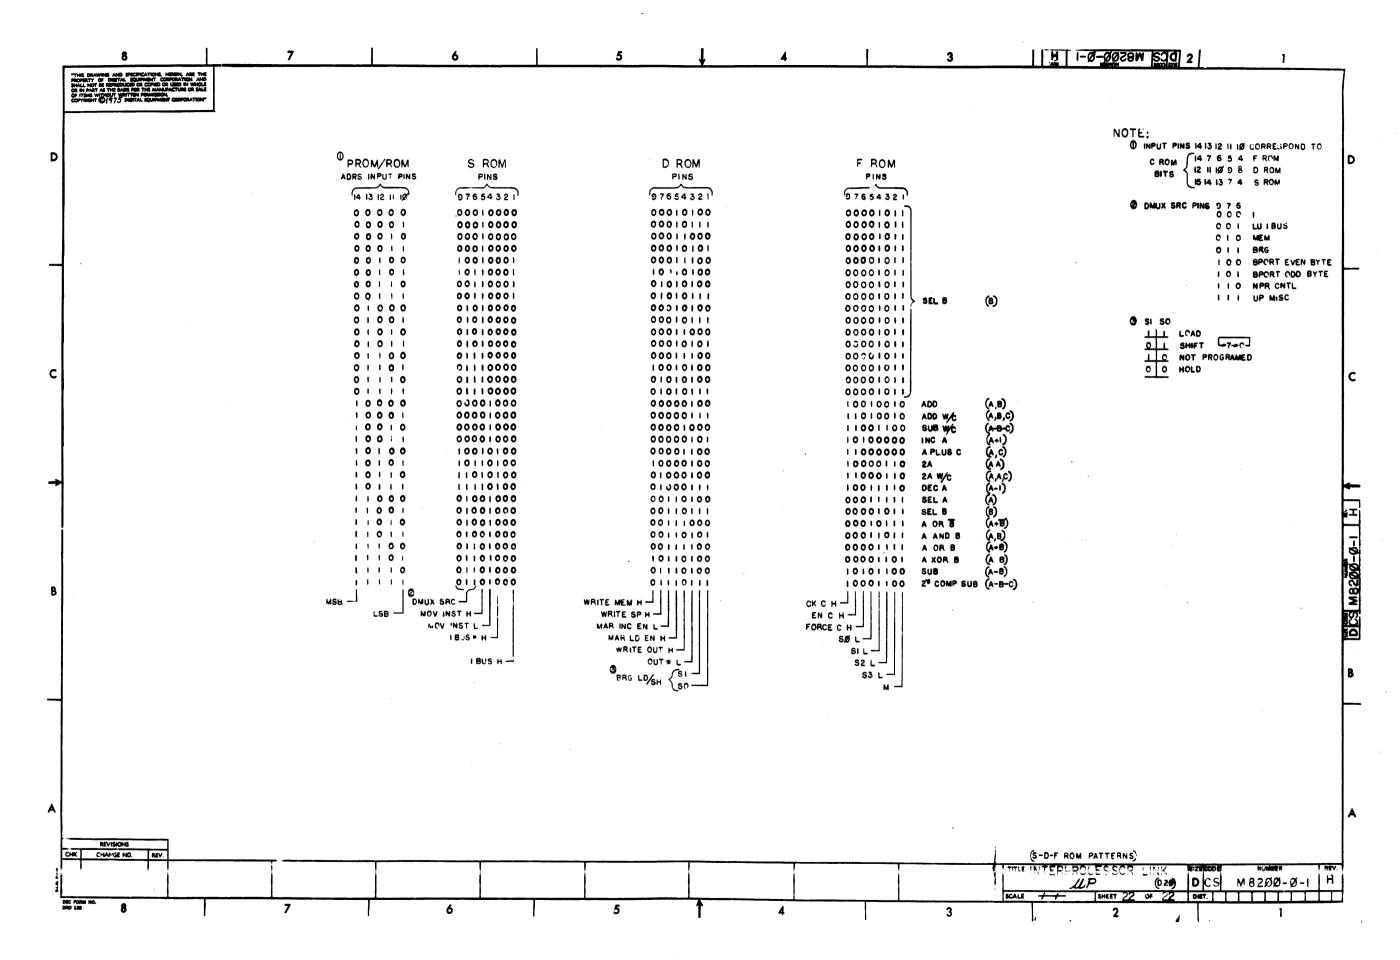


	DIGITAL		<del>,</del>	7	QUANT	ITY/	VARI	ATION	N	NOTES:					
DATI ENG DATI	R. Lie	PARTS CHECKED K. DATE 1- PROD R. Wa DATE 3-12-	GLEEZEN SECTION 1 ISSUED SECTION	age and a	øø-ya	200-тв									
ITEM NO.	DRAWING NO.	PART NO.	DESCRIPTION	M82ØØ	M82ØØ	M82						l		REF DESIGNATION	
1	D-CS-M8200-0-1		CIRCUIT SCHEMATIC	REF	REF	REF								,	
2	K-CO-M8200-0-4		X-Y COORDINATE HOLE LOCATION	REF	REF	REF							1		
3	D-AH-M8200-0-5		ASSY/DRILLING HOLE LAYOUT	REF	REF	REF									
4	в-мн-м8200-0-6		MODULE ECO HISTORY	REF	REF	REF							1		
5		5011842	ETCHED CIRCUIT BOARD	1	1	1									
6		1000023	CAP, 33C Pf. 100V	1	1	1							T	C112,	
7		1001610	CAP, .01 UF, 50V	102	102	102							C1-C61, C63-C69, C100-C102, C71- C94-C98, C104-C106, E103		
8		1000076	CAP, 39 Uf, 10V	3	3	3							C107, C108, C109		
9		1030042	CAP, 1000 Pf, 100V	4	4	4							1	C110, C111, C113, C123	
0		1004813	CAP, 10 Uf, 20V	7	7	7							C121, C114-C119		
1		1905547 -	IC, 7474	3	3	3							El17, El24, El29		
2		1905575	IC, 7400	2	2	2							E106, E109		
3		1905580	IC, 7450	2	2	2							E24, E116		
4		1900004	IC, 7402	2	2	2							1	E101, E115	
5		1909063	IC, 74H55	1	1	1		<b></b>					1	E91	
6		1909686	IC, 7404	4	4	4						_		E68, E70, E87, E126	
7		1909705	IC, 8881	4	4	4								E77, E78, E121, E123	
8		1909936	IC, 74151	9	9	9							E26, E57-E64		
9		1910087	IC, 4015	. 1	1	1							E72		
0		1910155	IC, 7408	5	5	, 5							E80, E105, E110, E114, E122		
20000	00003 00004 00006 00006	1910409	IC, 74H103	1	1	ı								E127	
HIS E ORPO ART ERME	DRAWING AND SPECIFICATIONS. IN S	FPPODUCED OR CORRED.	00 110 50 111 111111 - 111	CESSOF	LIN	IK UF			D-T	TA-M82	2 <u>øø</u> -ø-		B	NUMBER  REV.  M8288-8-8  BERTION PARTS LIST DATA BASE REV. C	

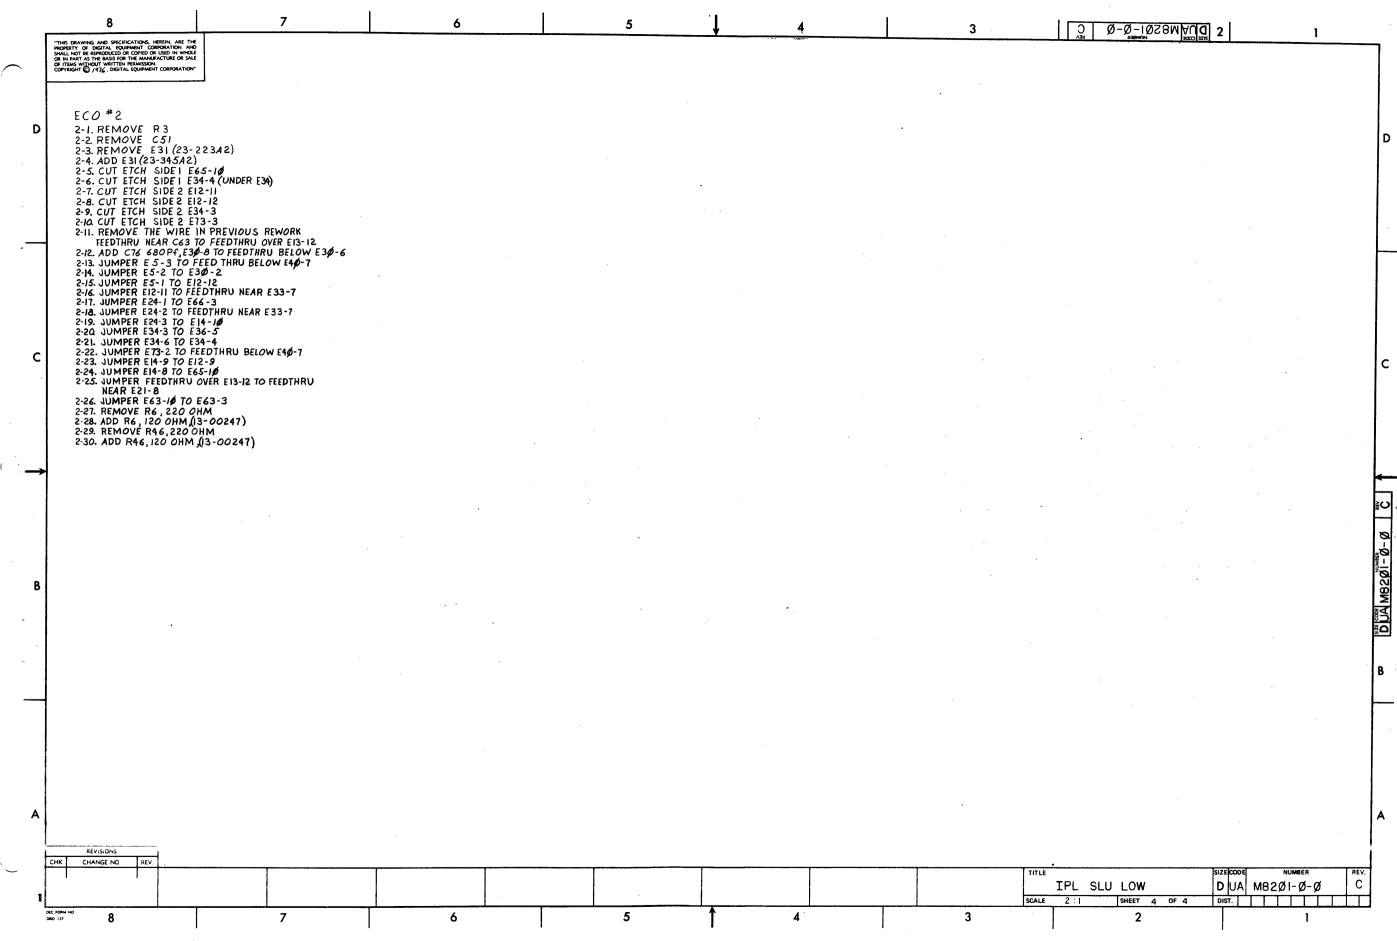

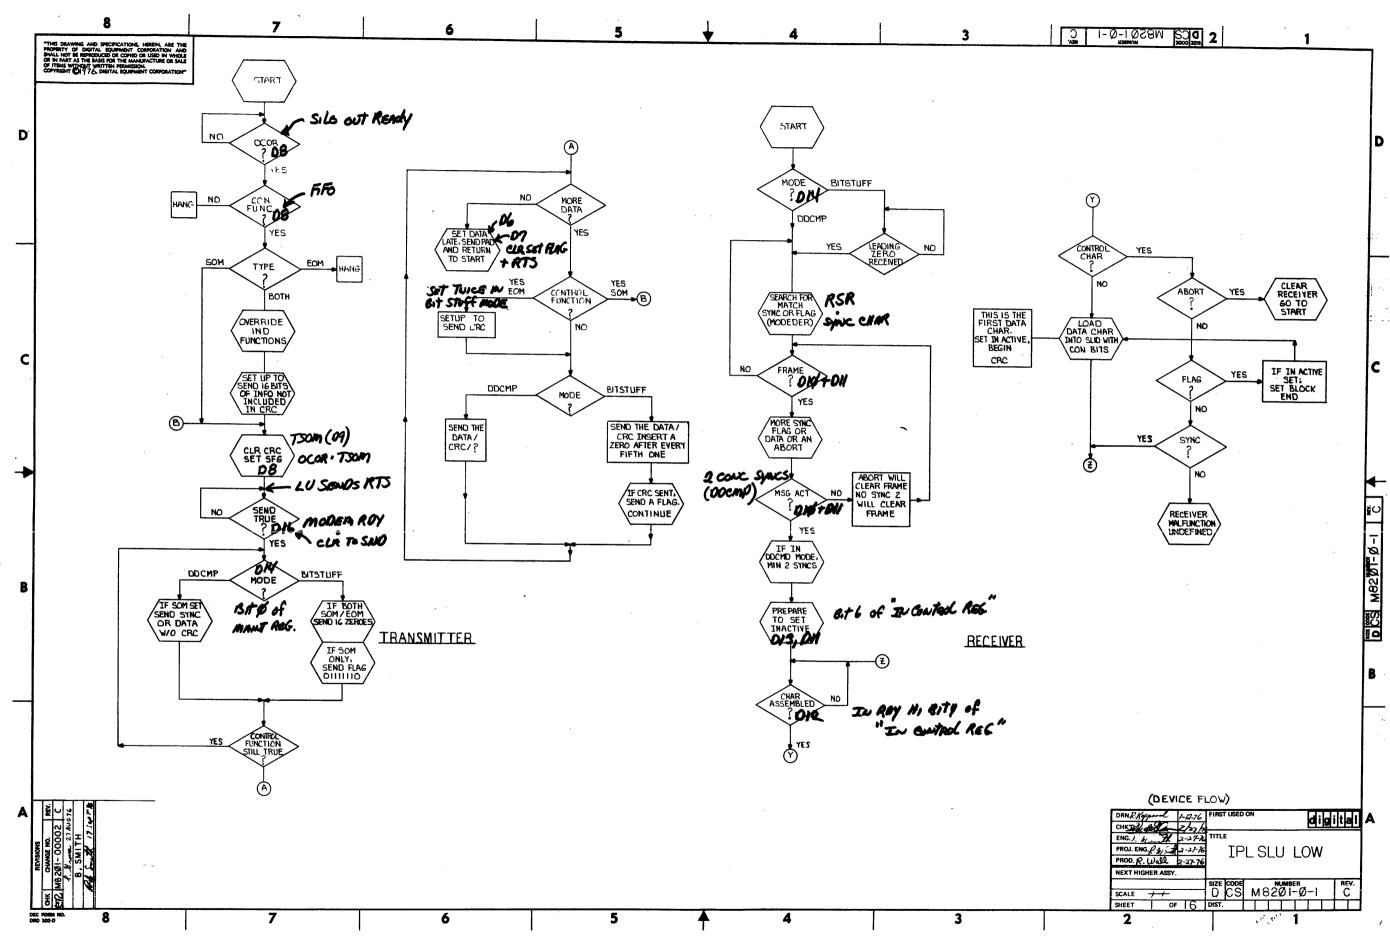



	DIGITAL E	QUANTITY/VARIATION										NOTES:			
PARTS LIST           MADE BY R. KOPPENAL DATE         CHECKED K. GLEEZEN L-27-76         SECTION L           DATE         1-27-76         1           ENG R. LISEE DATE         PROD R. WALL L         ISSUED SECTION L           DATE         3-12-76         1						200-yb									
ITEM NO.		PART NO.	DESCRIPTION	M82	M8200-YA	M82									REF DESIGNATION
83		23414A9	CROM, 512-1023 Bits 4-7	-	1	-	•					÷			Е6
84	•	23415A9 ·	CROM,512-1023 Bits 8-11	-	1	-									E7
85		23416A9	CROM,512-1023 Bits 0-3	-	1	-									E8
86		23417A9	CROM,512-1023 Bits 12-15	-	1	-									E9
87		23418A9	CROM,0-511 Bits 4-7	-	1	_									E14
88		23419A9	CROM, 0-511 Bits 8-11	_	1	-									E15
89	·	23420A9	CROM,0-511 Bits 0-3	_	1	-									E16
90		23421A9	CROM,0-511 Bits 12-15	-	1	-			1						E17
		Prior To Eco <sup>#</sup> 10								-					
						<b>\</b>	-				-				
E.C.O. NO	DRAWING AND SPECIFICATIONS. HE	REIN. ARE THE PROPI	ERTY OF DIGITAL EQUIPMENT TITLE				•		A	SSY					SIZE CODE NUMBER REV.
PAR PER	T AS THE BASIS FOR THE MANUFACT MISSION COPYRIGHT () /9"	SSOR	LIN	K UP	· ·		S	D-UA-M8200-0-0 SHEET 5 OF 5					B PL M82ØØ-Ø-Ø E INSERTION PARTS LIST DATA BASE REV		

OMC-24

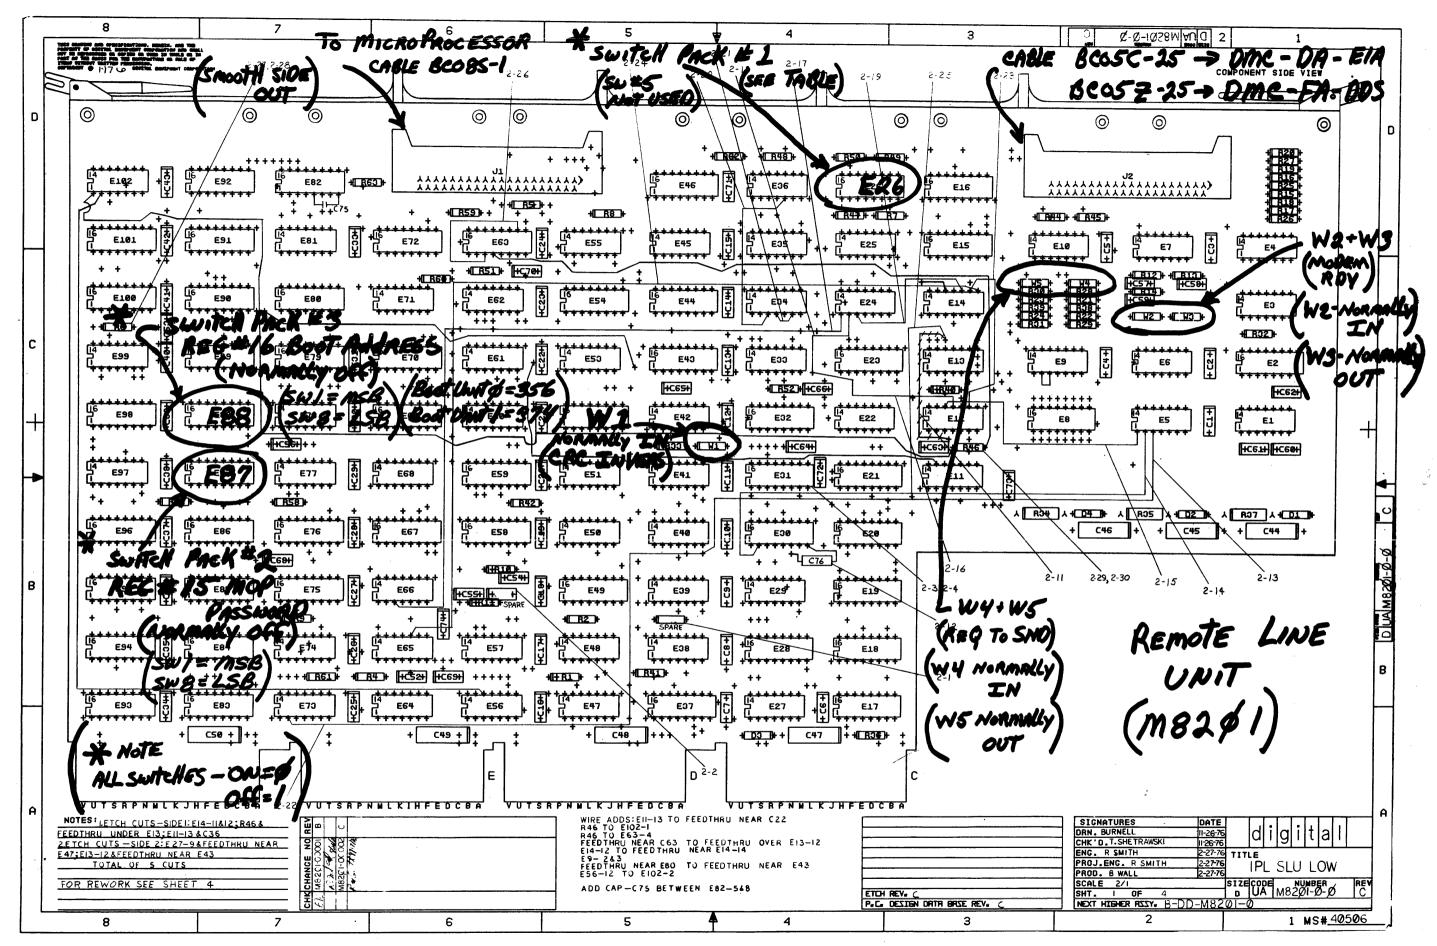



	8	7	6	5	4	3	1-Ø-IØZ8W SOD 2	1
(	THIS DRAWING AND SPECIFICATIONS, HEREIN, ARE TH- PROPERTY OF DIGITAL EQUIPMENT CORPORATION AND SPECIFIC OFFICIAL STATE OF THE MANUFACTURE OR SALL OF ITEMS WITHOUT WRITTEN PERMISSION. COPYRIGHT © 1976 DIGITAL EQUIPMENT CORPORATION	E 0 0 0 0 0 0 0 0 0 0 0 0 0 0 0 0 0 0 0						
D	SIGNAL NAME  D3 CROM 9 L (J2 - PP)  D3 CROM 1 L (J2 - UU)  D3 CROM 2 L (J2 - SS)  D3 CROM 3 L (J2 - RR)  D3 CROM 4 L (J2 - Y)  D3 CROM 5 L (J2 - AA)	3 4 5 6 7 8 9 19 11 12 13 14 15 16	05 W 18US 8 H (J2 - D) 3 05 W 18US 1 H (J2 - F) 3 05 W 18US 2 H (J2 - S) 3 05 W 18US 3 H (J2 - U) 3 05 W 18US 4 H (J2 - NN) 3	3 4 5 6 7 8 9 18 11 12 13 14 15 16 (	SIGNAL NAME DIØ RCOD H DII RSR Ø H DII FRAME (1) H DII IN ACT. (1) H DII MESS ACT. (1) H	3 4 5 6 7 8 9 18 11 12 13 14 15 1	SIGNAL NAME  3 4 5 6 7 8 9 18 1  D14 REG 15-8 H	11 12 13 14 15 16
	D3 CROM 6 L (J2 - CC)  D3 CROM 7 L (J2 - H)  D3 BT 249 H (J2 - V)  D3 IBR.* H (J2 - Z)  D3 IBR L (J2 - J)  D3 OBN L (J2 - TT)  D3 OBN L (J2 - X)  D3 BALU 9 L (J2 - DD)	X	D5 W 18US 6 H (J2- EE) D5 W 18US 7 H (J2- W) D6 DP H D6 DLO H D6 EN TX DONE H D6 SABORT H D6 SEL G H D6 SORC H	X X X X X X X X X X X X X X X X X X X	D11 RSR CLOOX D11 RSRC MAX H  D11 RSRP H  D11 RDR 7 H  D11 RDR 8 H  D11 RDR 5 H  D11 RDR 4 H  D11 RDR 3 H  D11 RDR 3 H	X X X X X X X X X X X X X X X X X X X	D14 REG 16-3 H	<del>^                </del>
C	D3 BALU   L (J2 - BB)   D3 BALU 2	X	D6 TX CLK L D6 TCP H D6 SSM H D6 BOCLRP L D6 SACT L D6 QUT ACTIVE H D6 DP L D7 CRC CLK BN H D7 SB LOAD H	X X   X   X   X   X   X   X   X   X	D11 NOR 1 H  D11 NOR 8 H  D11 NOR 3 H  D11 NOR 2 H  D11 NOR 1 H  D11 NOR 1 H  D12 IN RDY H  D12 IS 7 H	X X   X   X	DIS DTR (1) H	
· ·	D3 STEP LU H (J2 - B)  D3 RM (1) H (J2 - C)  D4 ALU 7 L  D4 ALU 6 H  D6 ALU 5 H  D6 ALU 5 H  D6 ALU 6 H  D6 ALU 5 H  D6 ALU 6 H  D6 ALU 6 H  D6 ALU 6 H  D6 ALU 6 H	X	07 EN TXSR H D7 LOND L D7 LOND H D7 TX SER OUT H D7 TCSC MAX H D7 TDLS D7 TDO  08.BTB Ø H D8 BTB I H	X	D12 IS 8 H D12 IS 5 H D12 IS 4 H D12 IS 3 H D12 IS 2 H D12 IS 1 H D12 IS 9 H D12 IS 8 H D12 IS 8 H	X	DIS CLOCK TRX  DIS CLOCK REC  DIS ROATA  DIS MODEM RDY  X  DIS MING H.  X  D8 TSIP L  X  X	X X   X X   X X   X X   X X   X X   X
В	D4 R12 SEL L D4 R13 SEL L D4 TBØ H D4 R17 SEL L D4 SWC 7 H D4 SWC 6 H D4 SWC 5 H D4 SWC 4 H	X	D8 BTB 2 H D8 BTB 3 H D8 000R H D8 000T RDY H D8 TEOM H D8 TS0M H D8 TS7M H	X X X	D12 80C MATCH H  D12 IN BLOCK END H  D12 ICIR H  D13 9C STATE H  D14 D00MP H  D14 ICLEP L  D14 OCLEP H	X	D11 RSR 5 H D11 RSR 4 H	X
-	D4 SYNC 3 H D4 SYNC 2 H D4 SYNC 1 H D4 SYNC B H D4 TB11 H D4 TB18 H D4 TB 9 H D4 TB 8 H	X   X   X   X   X   X   X   X   X   X	DE BTB 6 H  DE BTB 5 H  DE BTB 4 H  DE COCLR P L  DS TCRC OUT H  DS QO H  DIØ EN FRAME H  DIØ EN INACT H		D14 UCLEP H  D14 OC RP L  D14 NO CRC  D14 BIT STF H  D14 SET P  D14 SEC MODE  D14 SECURE H  D14 SW H	X		₩ B B
A	D4 TB 7 H  D4 TB 6 H  D4 TB 5 H  D4 TB 4 H  D4 TB 3 H  D4 TB 2 H  D4 TB 1 H  D5 RDAC P	X	DISS FLG RECO H	X	D14 REG 15-7 H D14 REG 15-6 H D14 REG 15-5 H D14 REG 15-3 H D14 REG 15-2 H D14 REG 15-1 H	X		A
	REVISIONS CHK CHANGE NO. REV.				-		TITLE IPL SLU LOW SIZECOOB D CS M8	
•	DEC FORMS RO. ORD 138	7 7	6	5	4	3	2	DMC-26

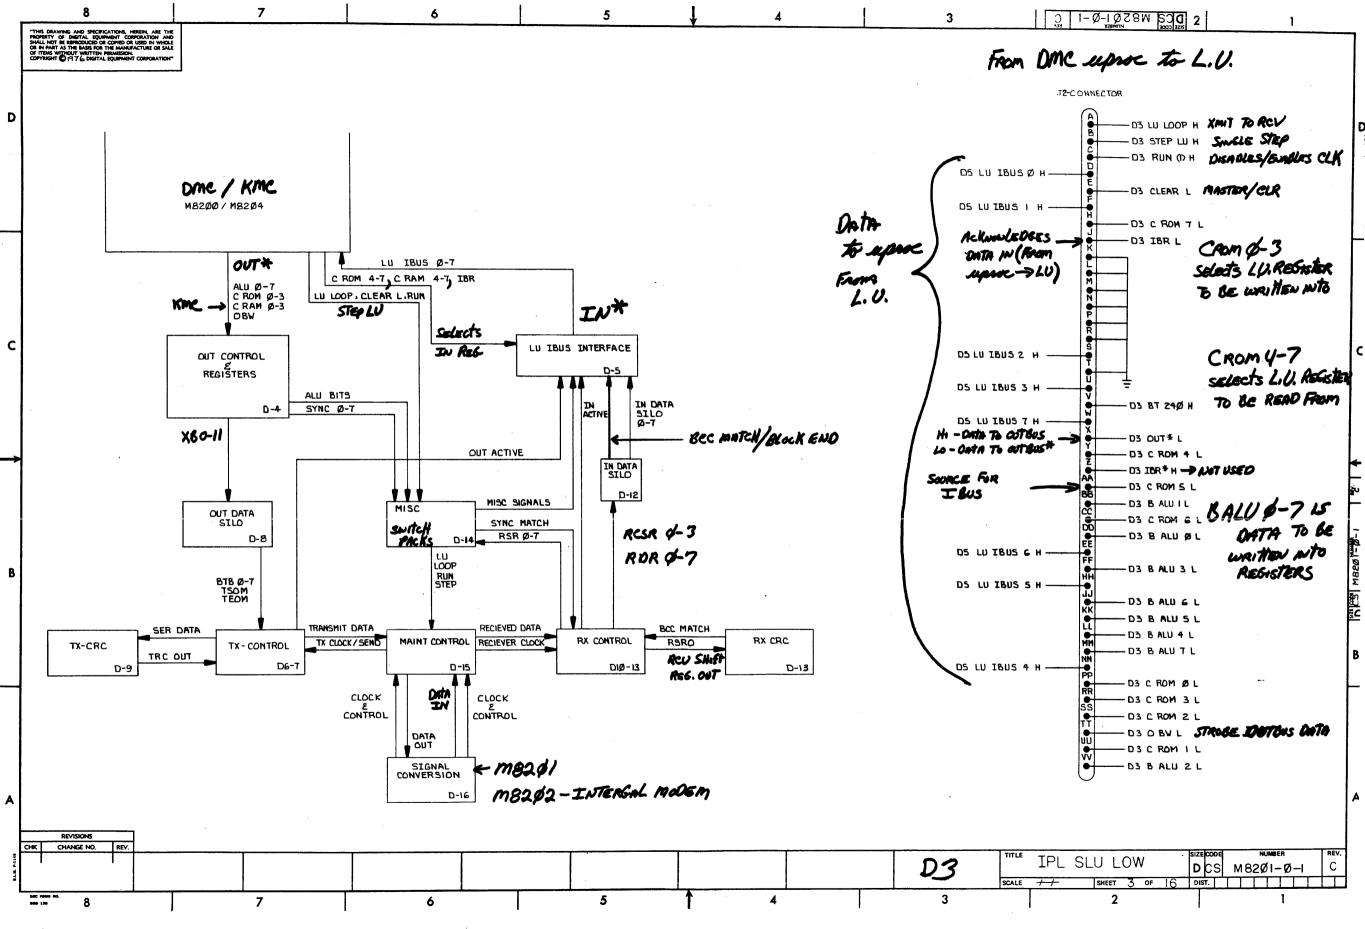


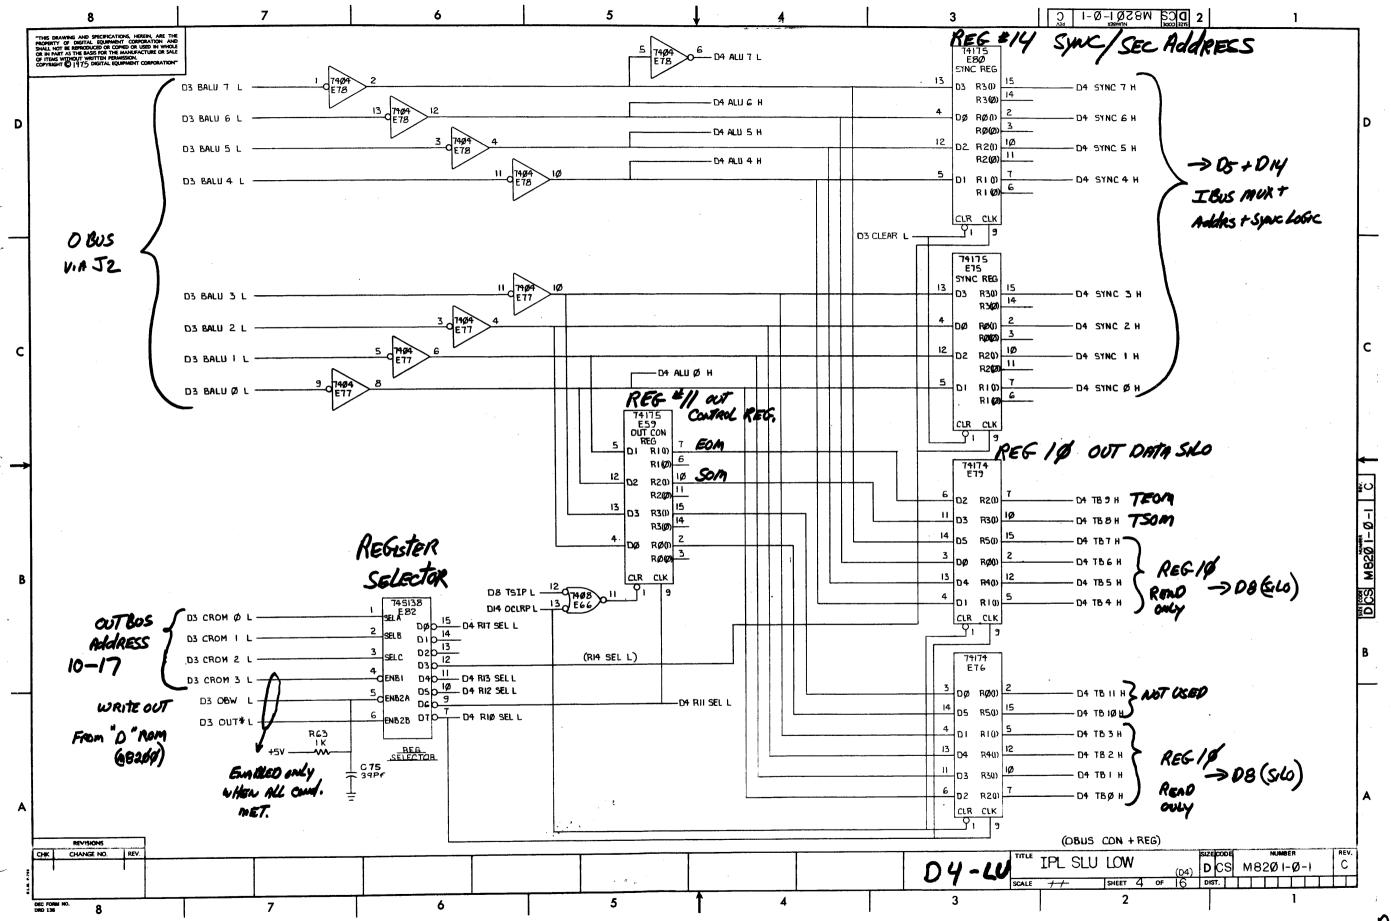



DMC-28

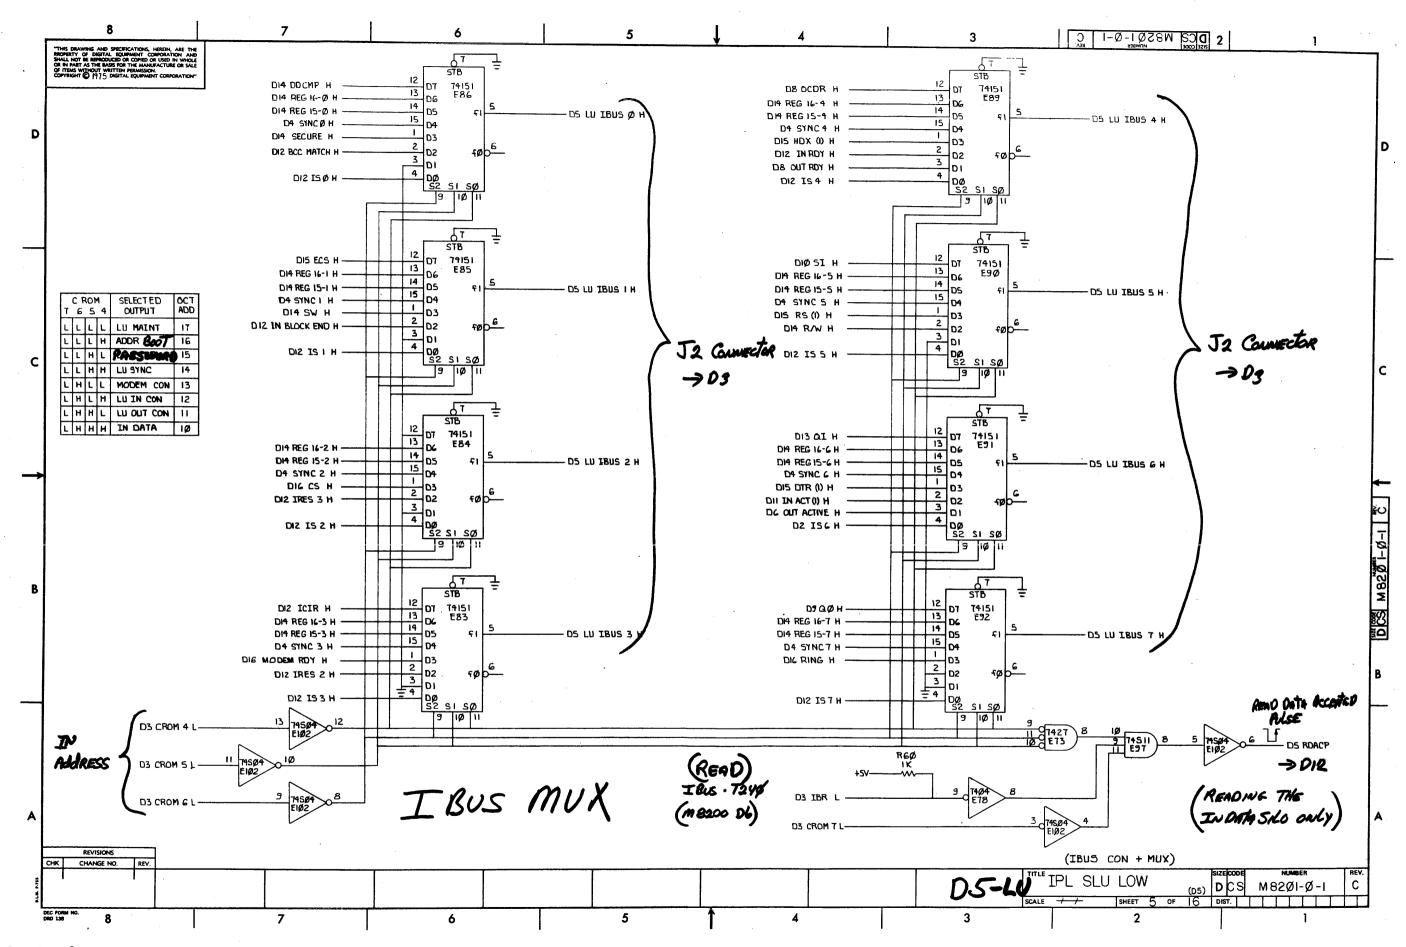


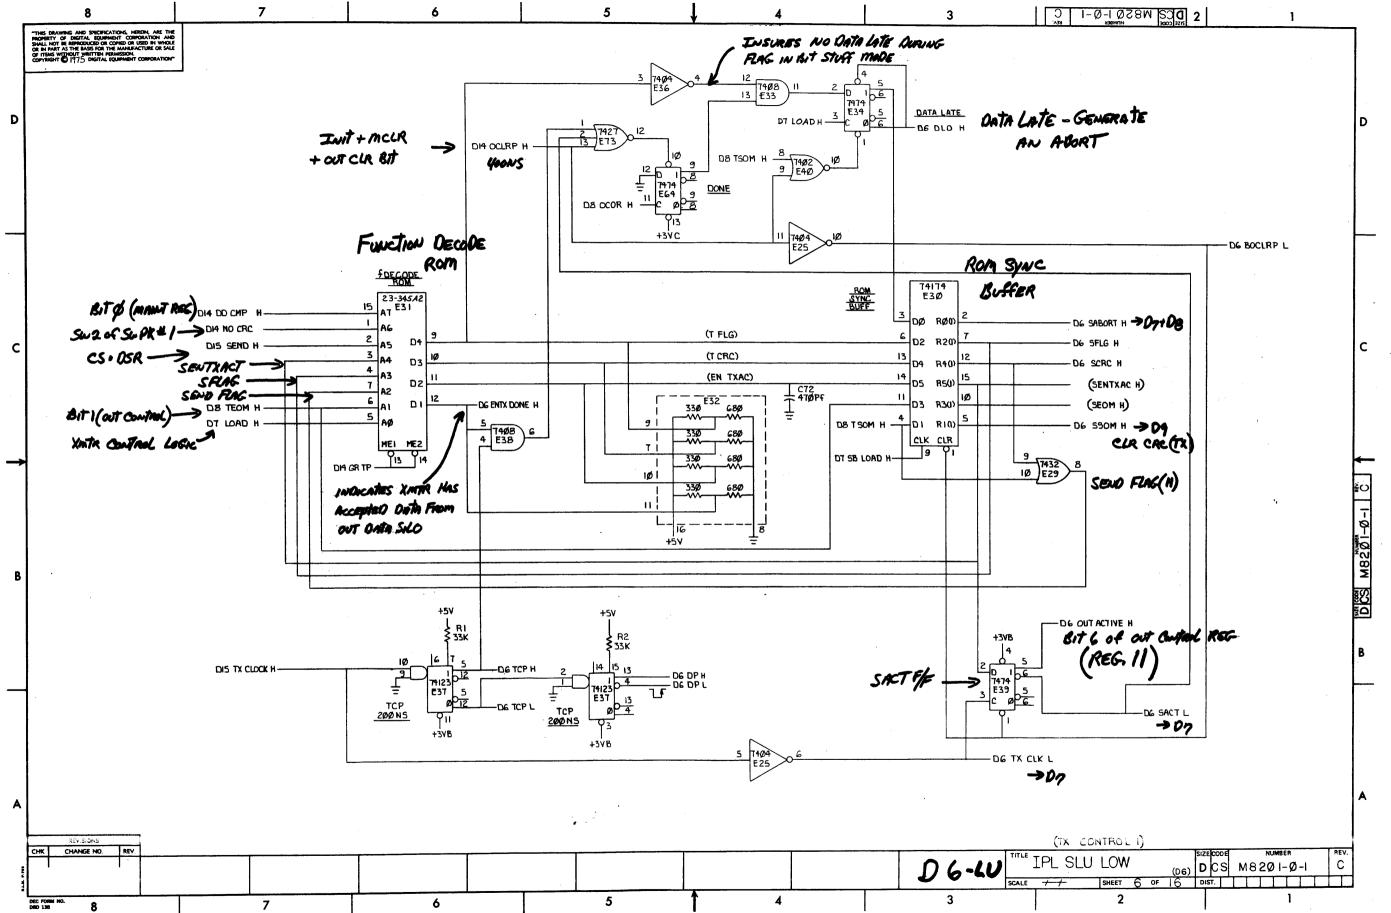


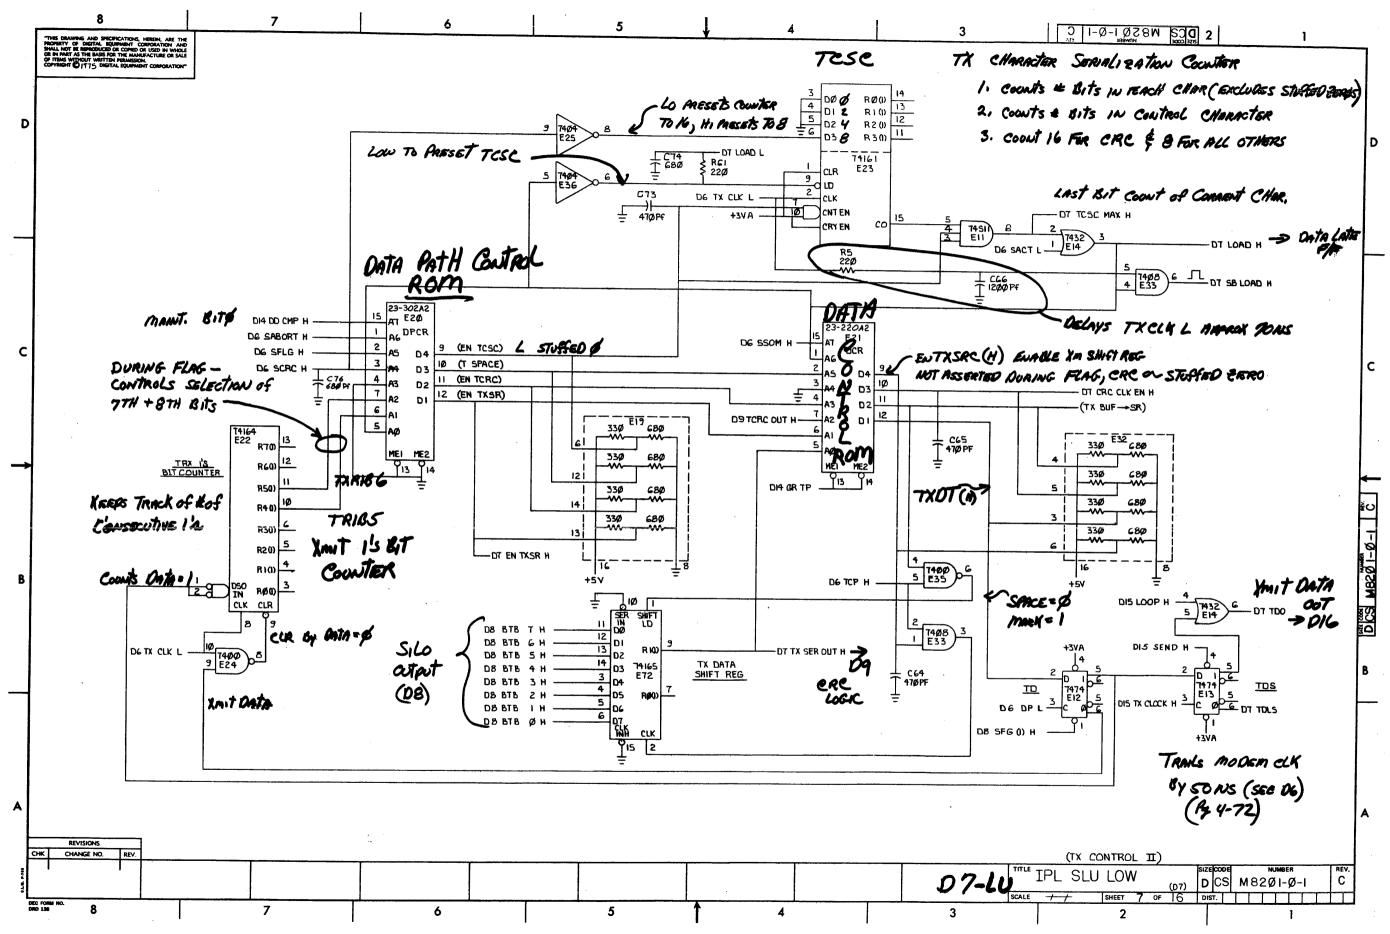


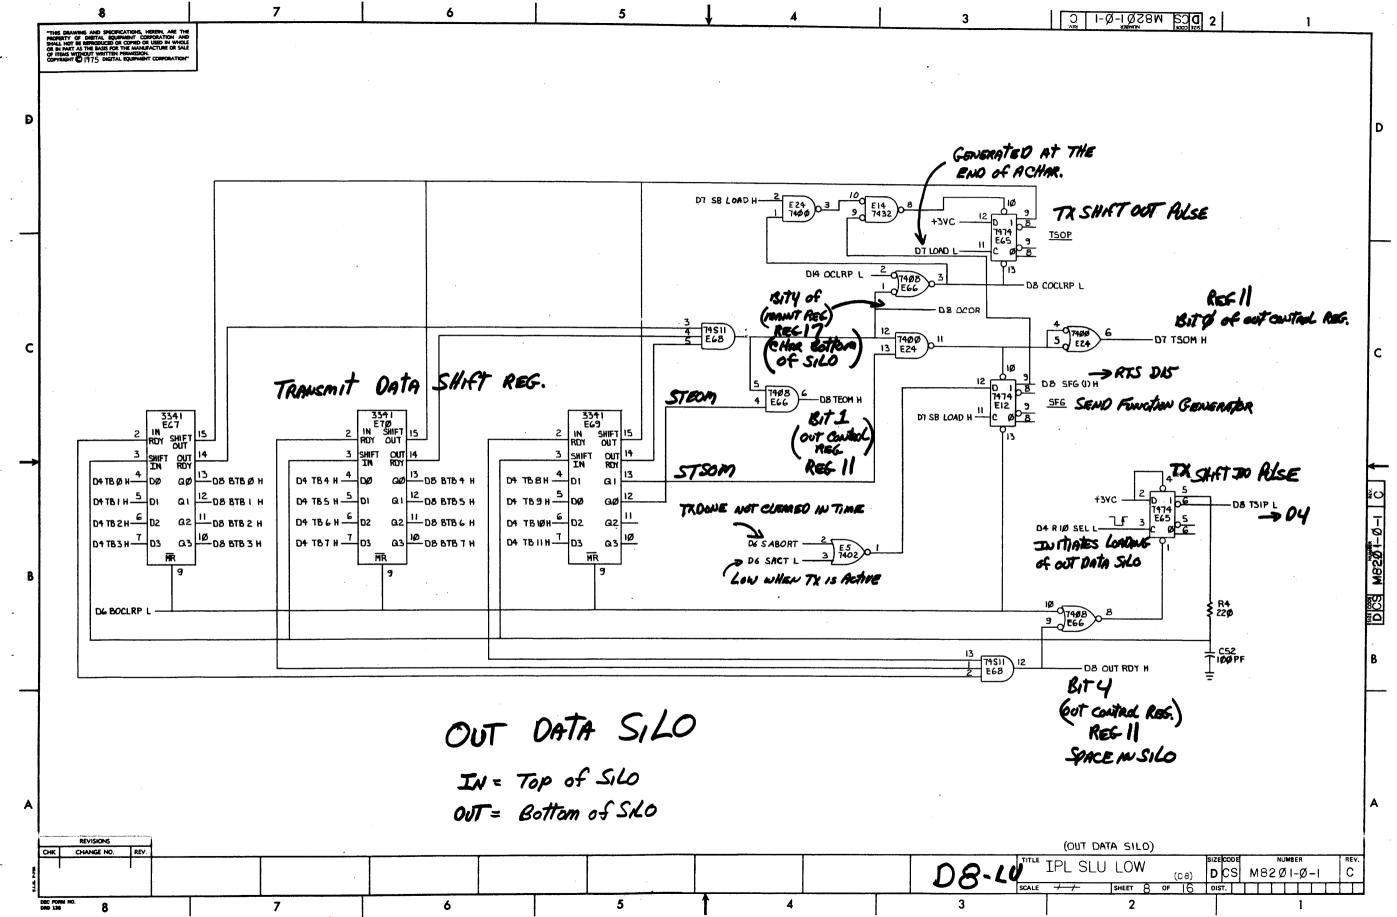


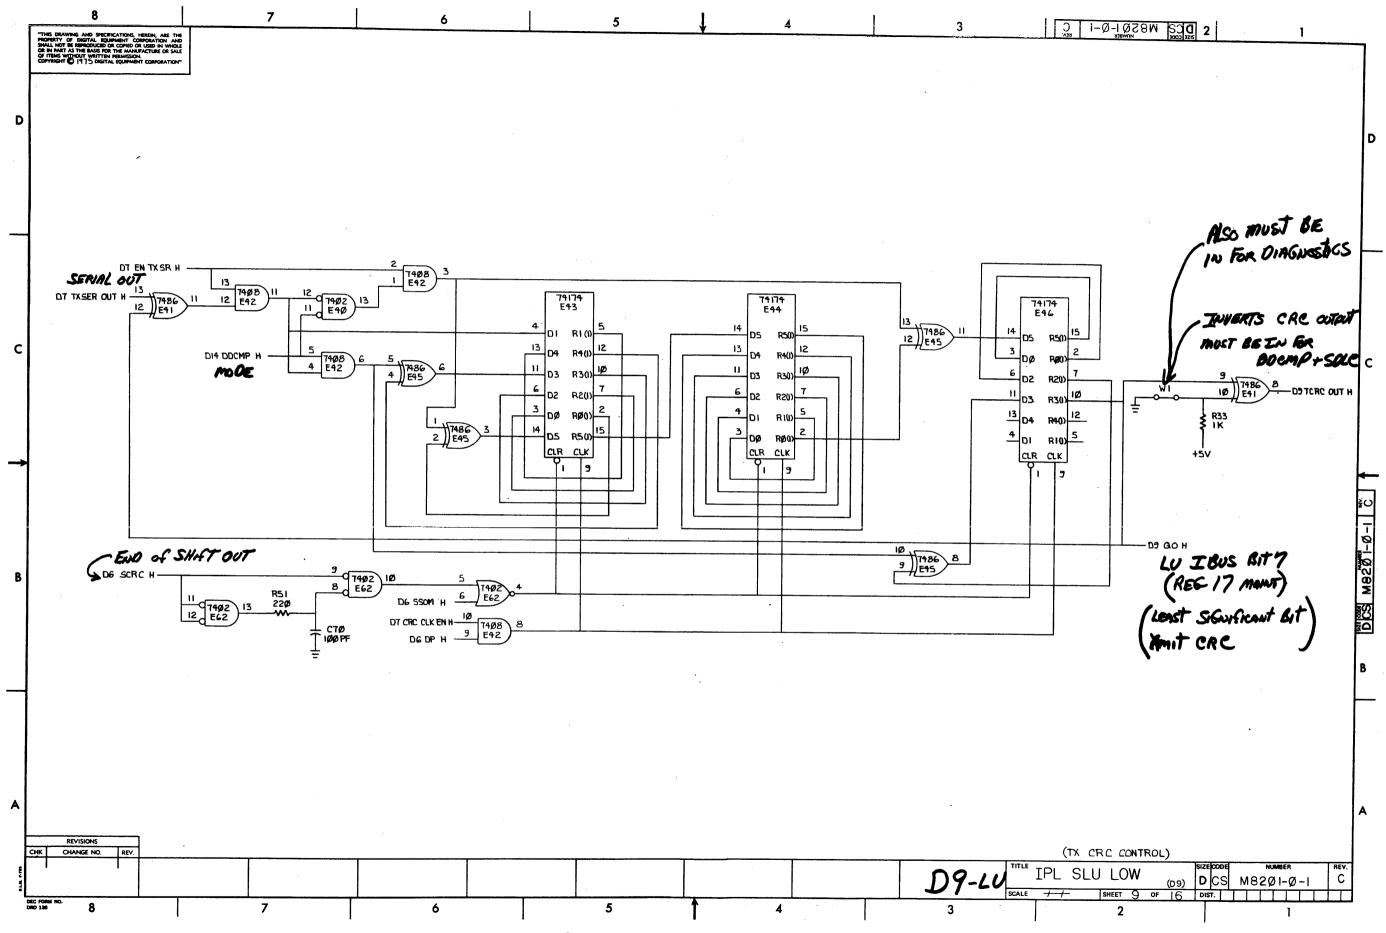


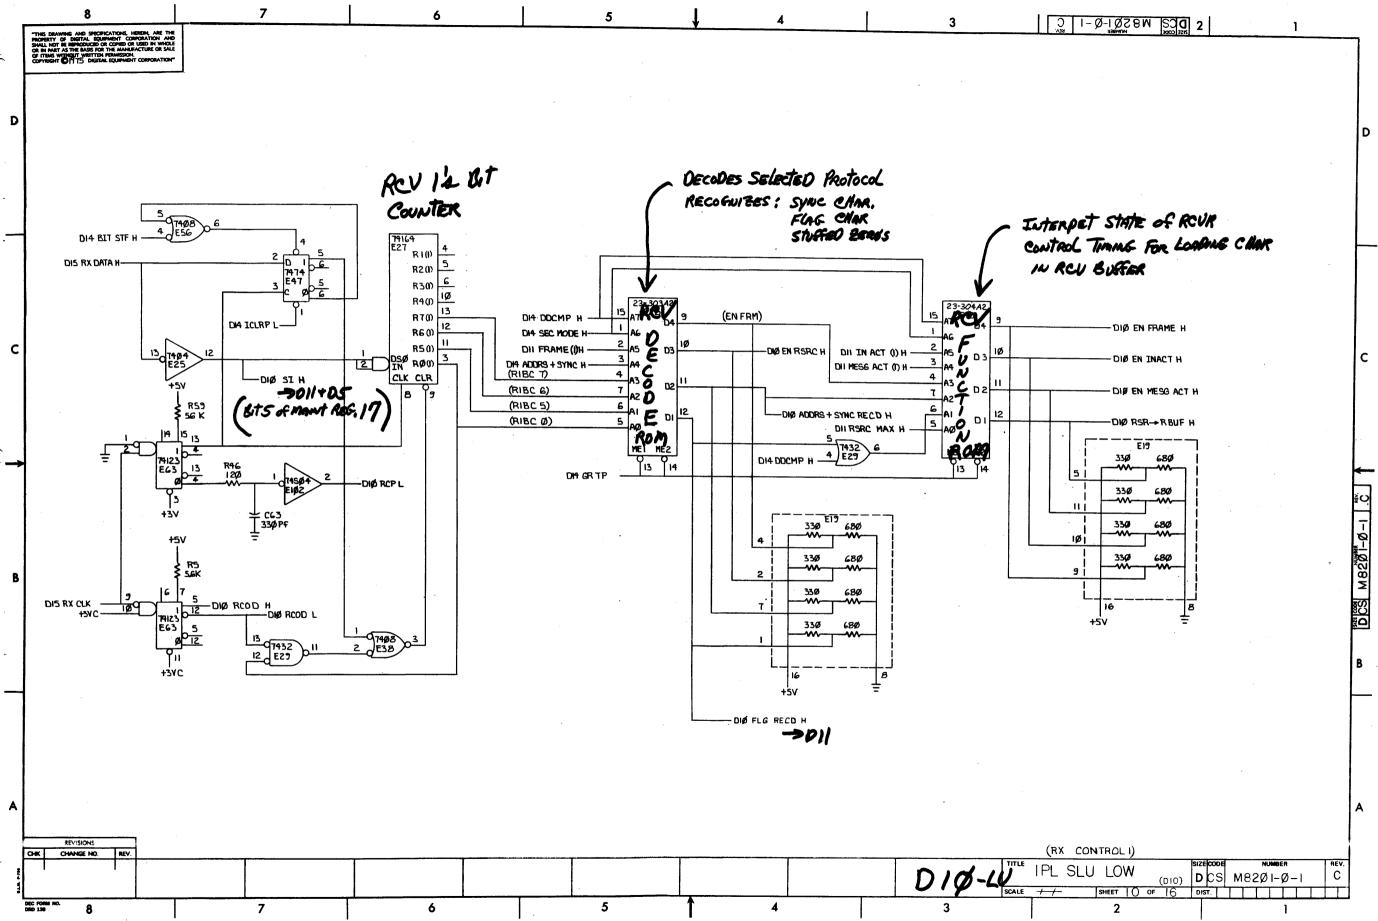


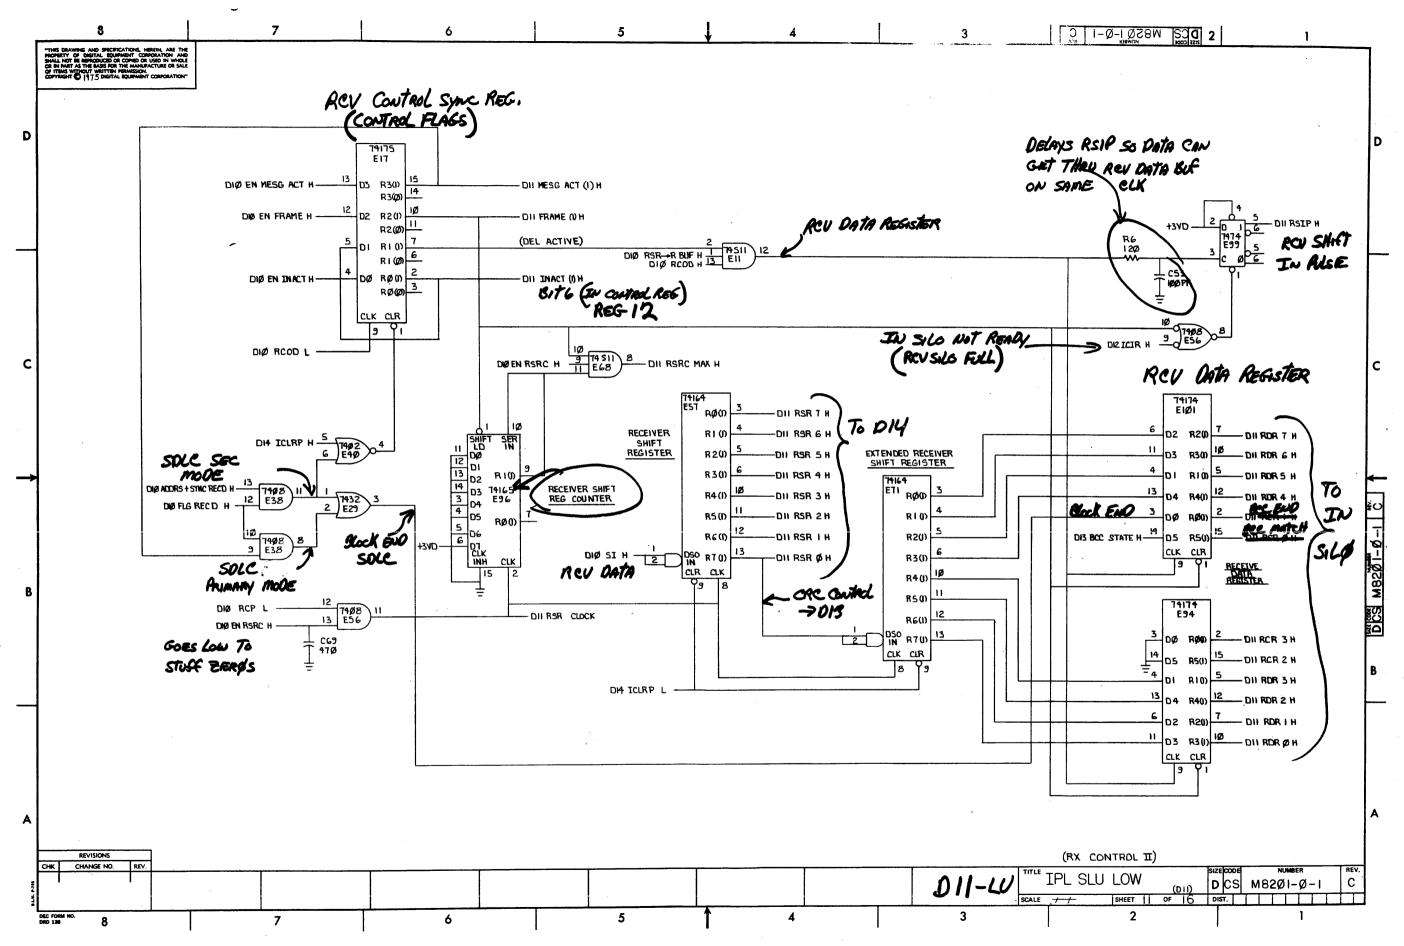


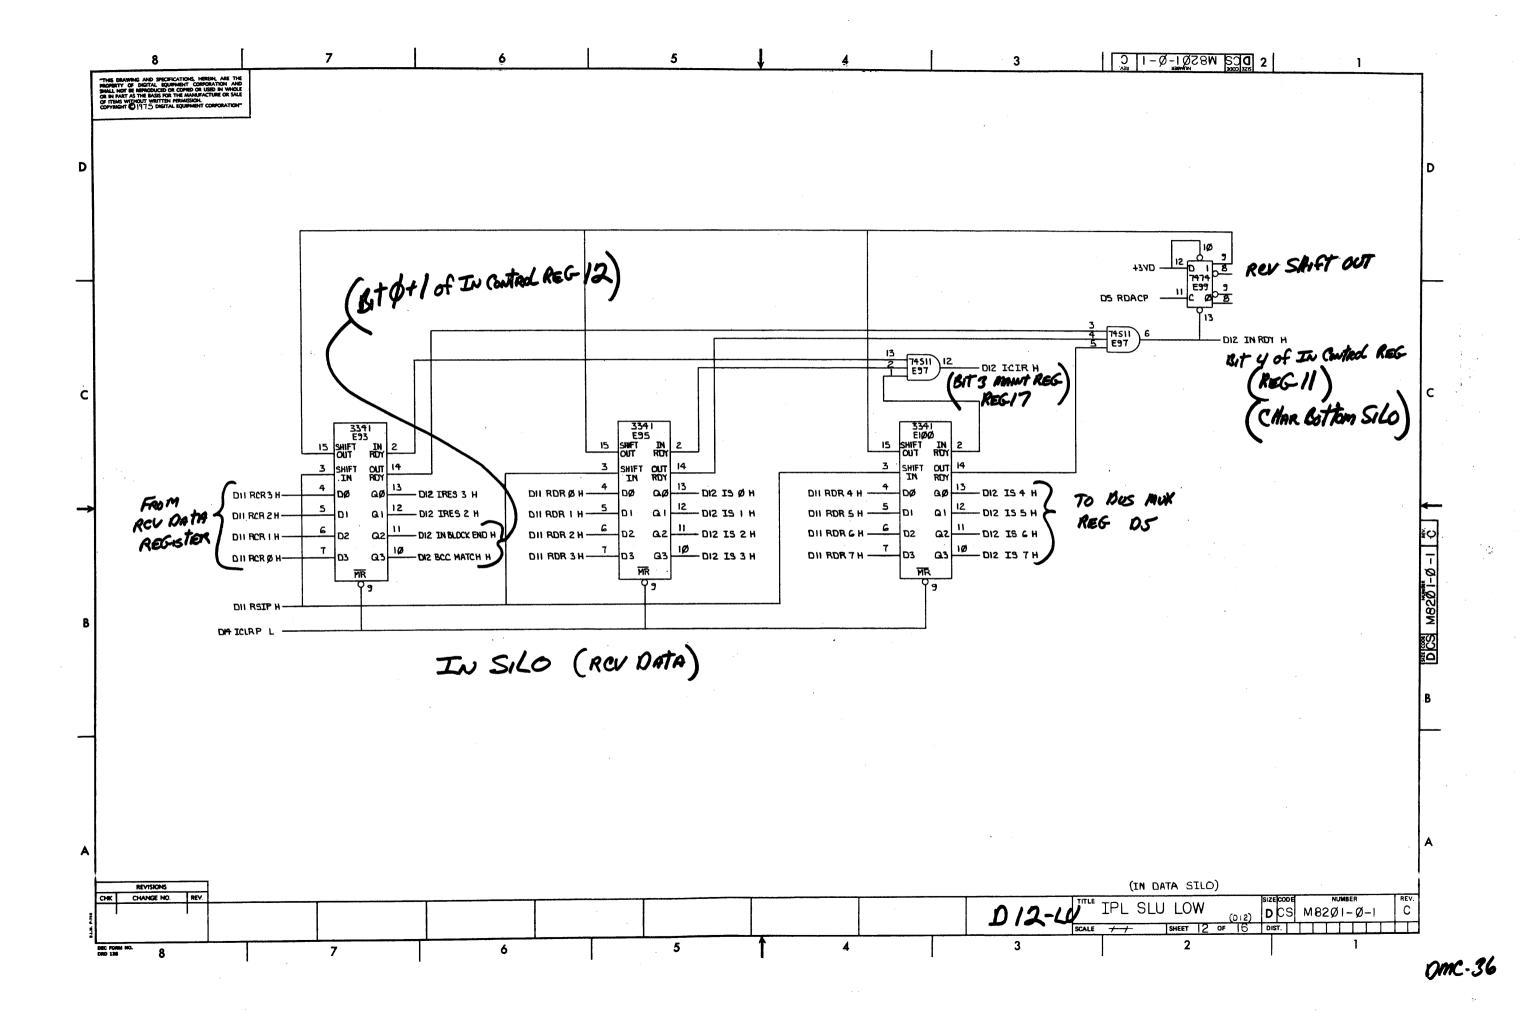

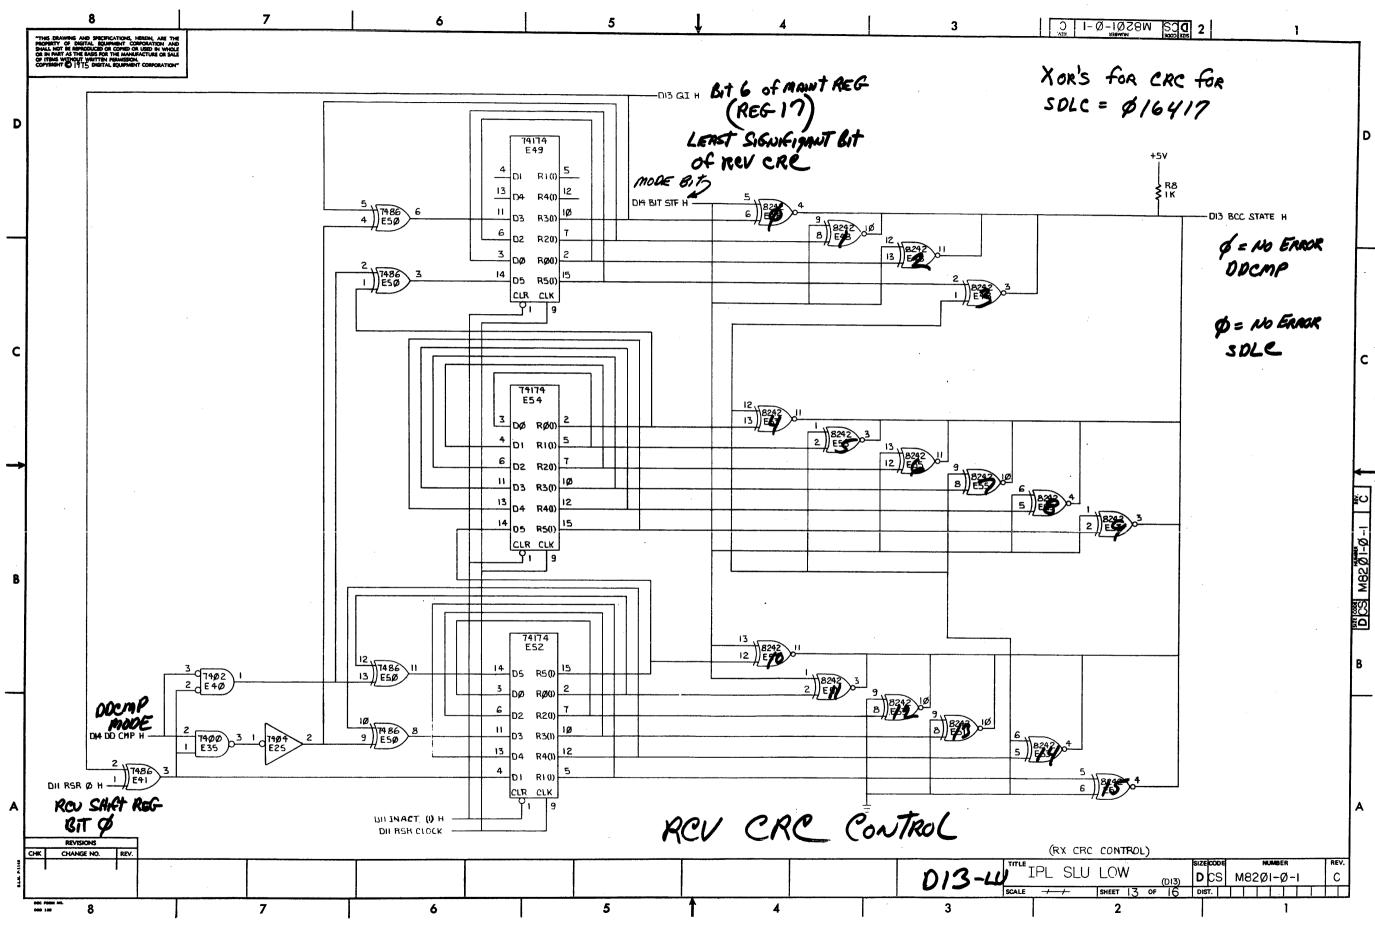

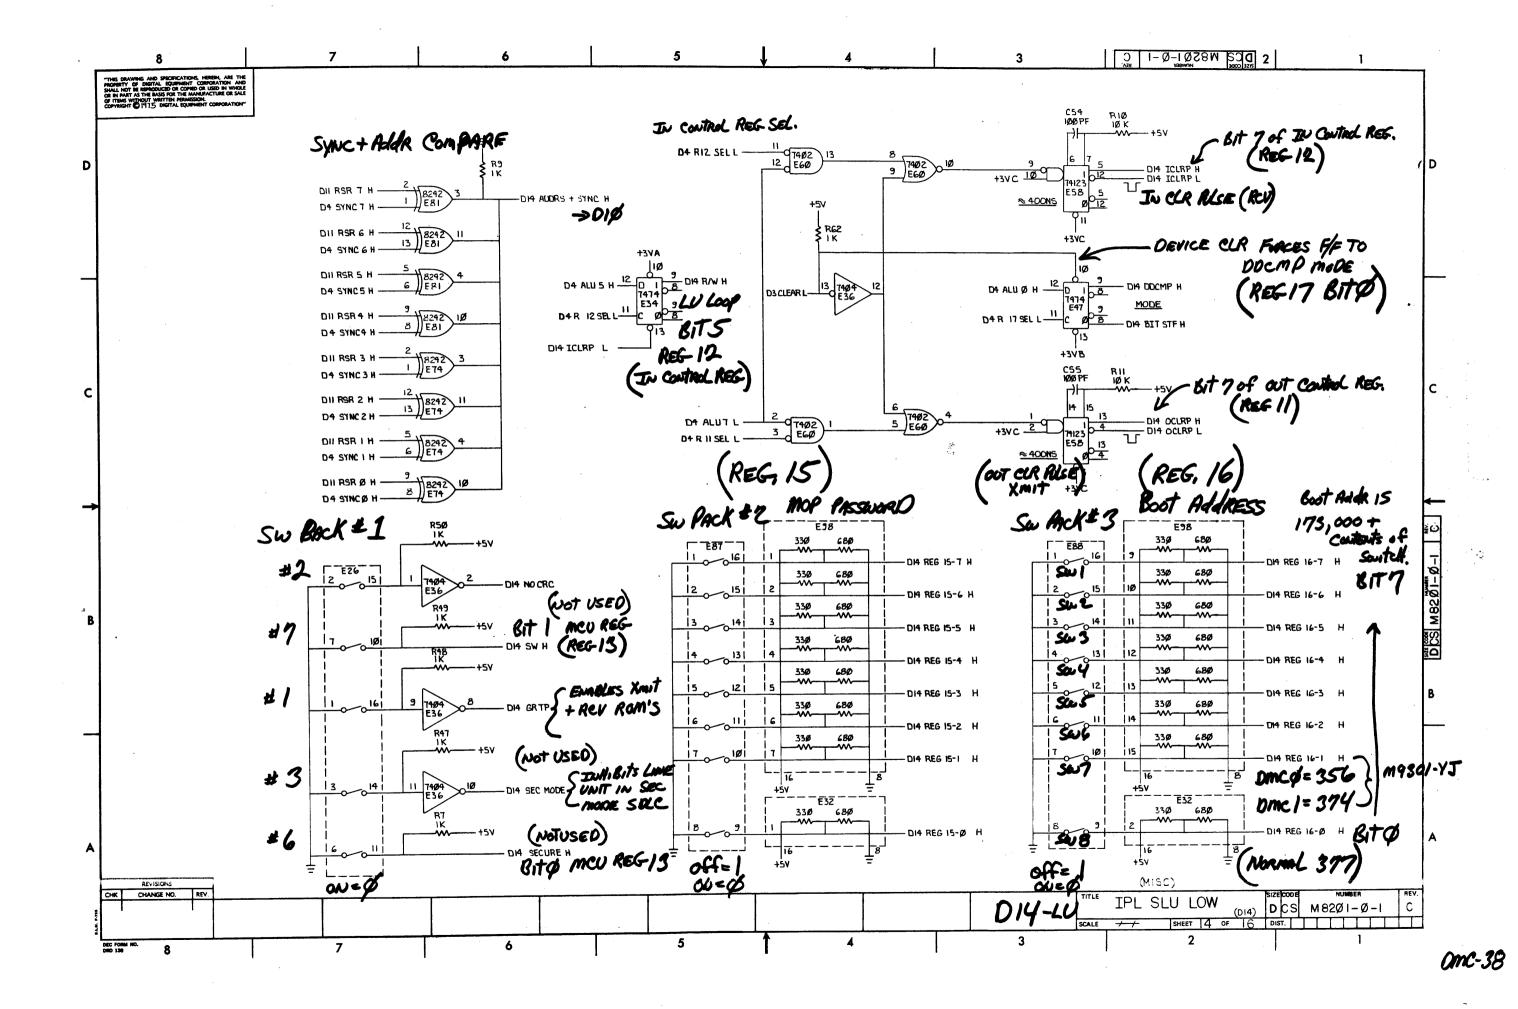

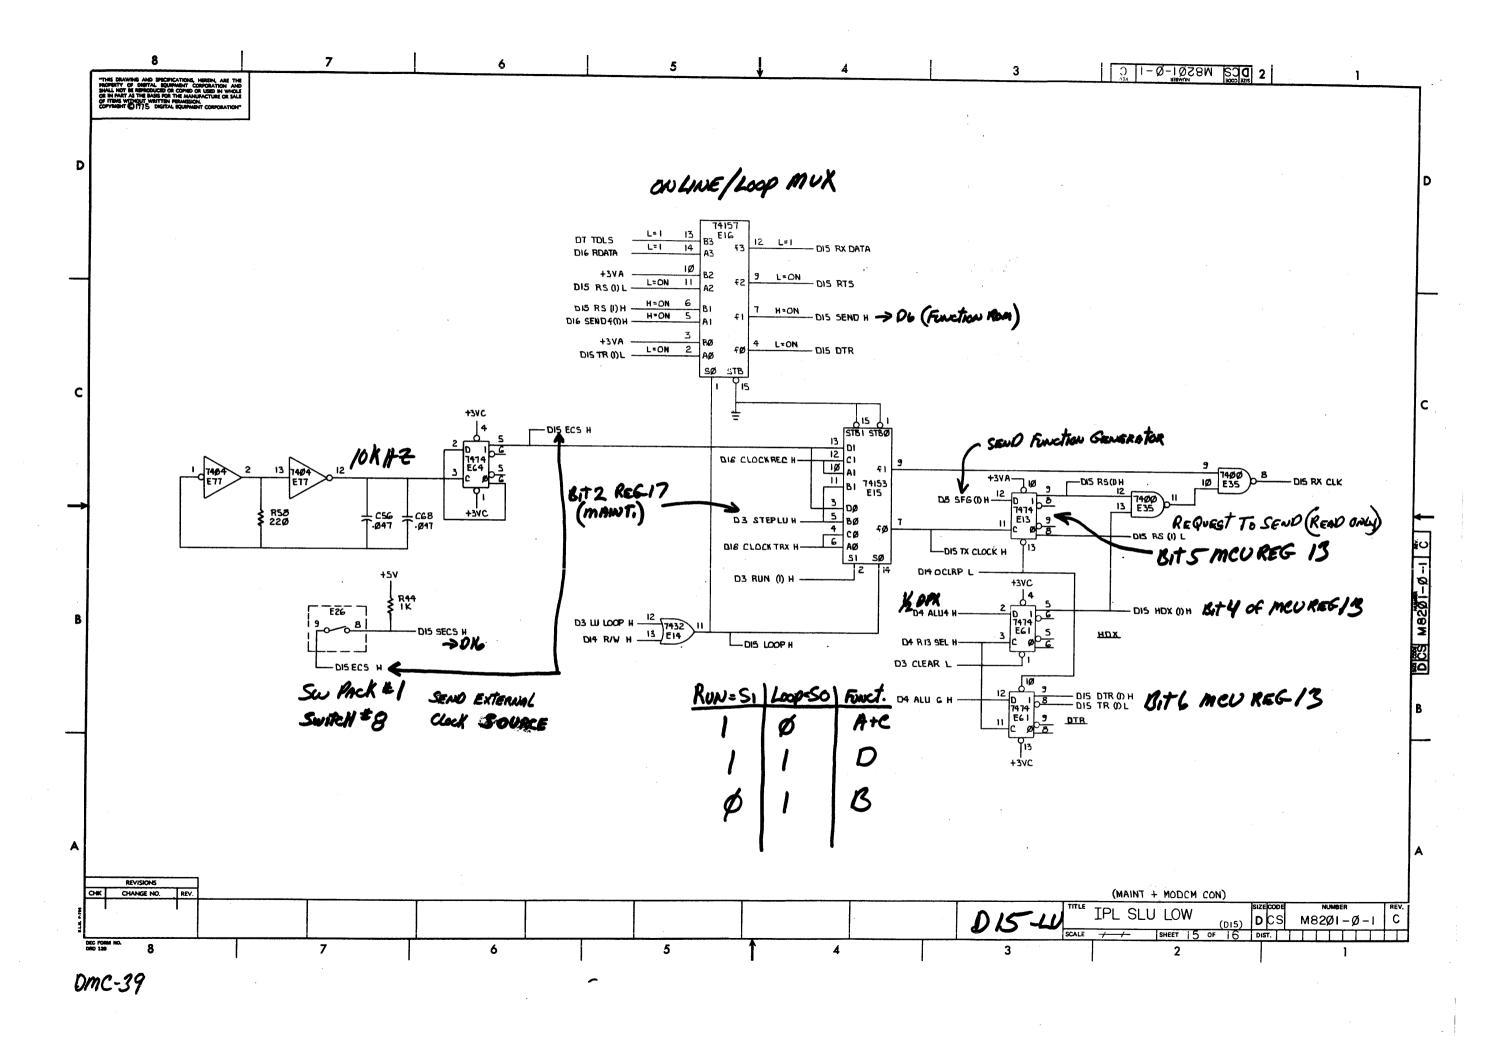

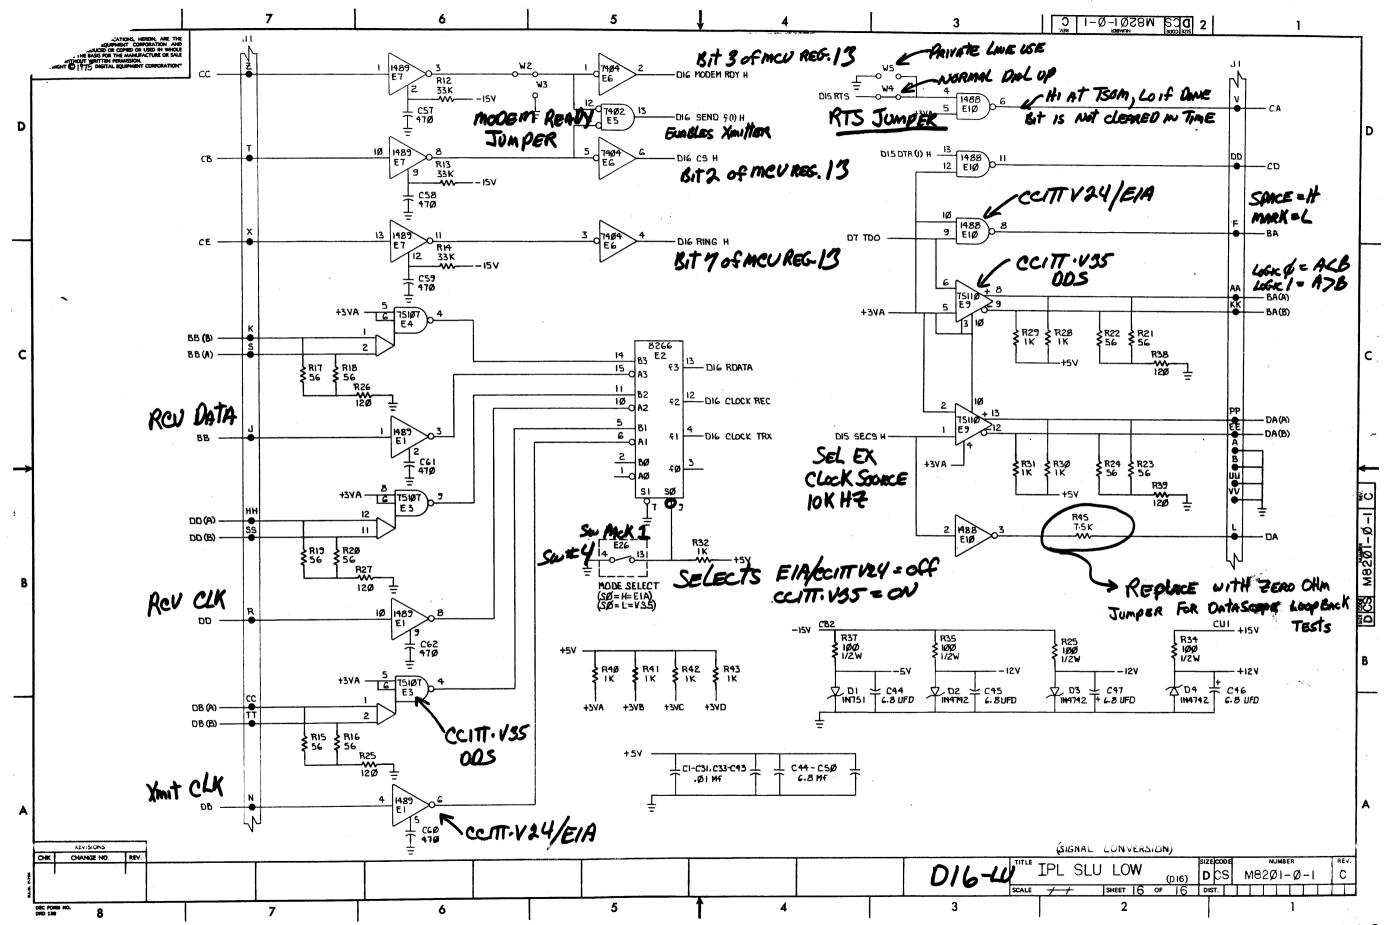

	DIGITAL		ā T T	UANTI	TY/VAF	HATION		NOTES: ** Any variation is acceptable		
MADE DATE ENG DATE	R. M. SMITH	PARTS CHECKED KEN DATE 3-2 PROD R. 1 DATE 3-2	F GLEEZEN SECTION 1-76 ISSUED SECTION						·	
ITEM NO.	DRAWING NO.	PART NO.	DESCRIPTION							REF DESIGNATION
1	D-MD-5011711	5011711	ETCHED CIRCUIT BOARD	1					į	
2		1000016	CAP, 100 Pf, 100V	5						C52-C55, C7Ø
3		1000024	CAP, 470 Pf, 100V	11						C57-C62, C64, C65, C69, C72, C73
4		1001610 **	CAP, .01 Mf, 50V	43						C1-C31, C71, C33-C43
5		1005306	CAP, 6.8 Mf, 35V	7	1 1					C44-C5Ø
6		1010978-32	CAP, .Ø47 Mf, 5ØV	2						C56, C68
7		1109502	DIODE, IN4742	3						D2-D4
8		1110994	DIODE, IN751A	1						D1
9		1905547	IC, 7474	9						E12, E13, E34, E39, E47, E61, E64, E65, E99
10		1905575	IC, 7400	2						E35, E24
11		1909004	IC, 7402	4	1					E62, E4Ø, E6Ø, E5
12		1909686	IC, 7404	5	1					E6, E25, E36, E77, E78
13		1909712	IC, 8242	6	<del></del>	1				E48, E51, E53, E55, E74, E81
14		1909934	IC, 8266	1						E2
15		1909936	IC, 74151	8	1	_				E83-E86, E89-E92
16		1909937	IC, 74153	1	1					E15
17		1910011	IC, 7486	3	1 1					E41, E45, E5Ø
18		1910041	IC, 74164	4						E71, E22, E27, E57
19		1910155	IC, 7408	5						E33, E38, E42, E56, E66
20		1910268	IC, 75107	2	1					E3, E4
21		1910322	IC, 1488L	1	1 1					E10
M8291-1	2-1 Ø28w		•							·
THIS DECORPOR	RAWING AND SPECIFICATIONS, RATION AND SHALL NOT BE R S THE BASIS FOR THE MANUF	REPRODUCED OR COPIED FACTURE OF T	OR USED IN WHOLE OR IN EMS WITHOUT WRITTEN	IPL SLU LOW				5-UA-M82Ø1-Ø		SIZE CODE NUMBER REV.  B PL M82Ø1-Ø-Ø C
PERMIS:	SION COPYRIGHT (C) 40A-16-R276(325)	1976 . DIGITAL EQUIP	MENT CORPORATION"	TIE SHO DON			SHEE	T 1 OF	3	INSERTION PARTS LIST DATA BASE REV C

DMC-41

DIGITAL EQUIPMENT CORPORATION PARTS LIST					QUANTITY/VARIATION								NOTES:	
MADE E DATE ENG DATE	R. KOPPENAL 1-12-76 R. M. SMITH 3-2-76	CHECKED KEN DATE 3-2 PROD R.			1									
ITEM NO.	DRAWING NO.	PART NO.	DESCRIPTION										REF DESIGNATION	
42		1309247	RES, 120, 1/4W, 5%	7					T				R25-R27, R38, R39,R6,R46	
43		1302602	RES, 56, 1/4W, 5%	10		1			1				R15 - R24	
44		1311003-02	RES, PACK	3			1						E19, E32, E98	
45	• •	1301422	RES, 7.5K, 1/4W, 5%	1		11	-		1				R45	
46	The second secon	1000023	CAP, 330 Pf	1		1-1			1				C63	
47		1301874	RES, 5.6K, 1/4W, 5%	1		† †	1	1-1-	1				R5	
48		1302395	RES, 56K, 1/4W, 5%	1		† †		1	$\top$	+			R59	
49		1000010	CAP, 39 Pf	1		11			$\top$				C75	
50		23-345A2	ROM 256 X 4 OC (T1)	1	-	1 1		† †				,	E31	
51		23-220A2	ROM 256 X 4 OC (T3)	1	İ	1 1	1	1	1		4	1,14	<b>21</b>	
52	, elementaria de la composição de la com	23-302A2	ROM 256 X 4 OC (T2)	1		1 1		11	$\top$		1		E2Ø	
53		23-303A2	ROM 256 X 4 OC (R1)	1				† †	+	_			E28	
54		23-304A2	ROM 256 X 4 OC (R2)	1		1 1		1	7	_			E18	
55	en anno de la casa de	1002424	CAP, 1200 Pf, 100V	1	-		· · · ·   - ·		+	· <b>†</b> -	† <u>-</u>		C66	
56		9107256-10	CLEAR TUBING	A/F		† †		1	1					
57		1000026	CAP, 68# Pf, 1##V	2	.	1 1	t	1 1	1				C74,C76	
58		900 ) 185	INSULATED JUMPERS	3	_   _	<del>-  </del>		+-+	+	1-	+		W1, W2, W4	
59	The district resources of an interest of the angle again.	1203941-02	CONNECTOR	2	1	1 1	1	1	+				J1, J2	
60		1210711-02	HEX HANDLE		1	1 1	İ	† †-						
61	•	9103740-55	3Ø AWG WIRE	Λ/#	1	1 1	·	1 1	ł	1				
62	<del>-</del>	9006732	EYELETTES	12		1 1	Ì	1 1	1	1	1			
63		1211164-04	SWITCH PACK - 8 PER PACK	3	L			<u> </u>	1				E26, E87, E88	
UNTURAL	TON AND SHALL NOT BE R THE BASIS FOR THE MANUF	EPHODEICED OD CODIED.	ERTY OF DIGITAL EQUIPMENT, OR USED IN WHOLE OR IN EMS WITHOUT WRITTEN	IPL SLU I	,OW				A-M	82Ø1-Ø			SIZE CODE NUMBER REV. BPL M8201-0-0 C	
	1-16-R276(325)	DRB 125	ENI CONFORMINE			······································		SHEET	3	OF	3		INSERTION PARTS LIST DATA BASE REV C	

